Sheet No. 1

Township No. 19 N., Range No. 10 West Mer. (Mich.)

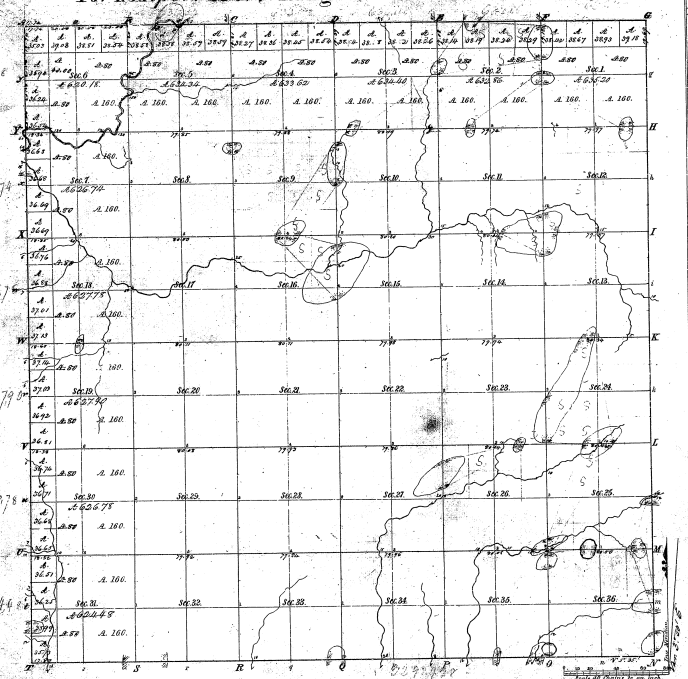

Meanders of

Posts	Courses	Dist.	Posts	Courses	Dist.	Posts	Courses	Dist.

11-6

Total number of Acres. 23924.38

Surveyor-Geneals Instructions	Date when Received	Date of Contract	Amount of Purchase	When Surveyed	When Plat'd for and off'd in the Land Office	
Township lines	John Ghesterson	June 18th 1839	23 23 77	1st Jy 1839	1st Jy 1839	
Subdivisions	Jos. Wm. Ashley	Jan 29th 1838	23 23 77	2d Jy 1838	1st Jy 1839	

The above Map of Township No. 19 North of Range No. 10 West of the Principal Meridian Michigan is strictly conformable to the field notes of the survey thereof on file in this Office, which have been examined and approved.

Surveyor General's Office
Cincinnati, Oh. 22d 1839

C. P. Claiborne
Surr. Genl.