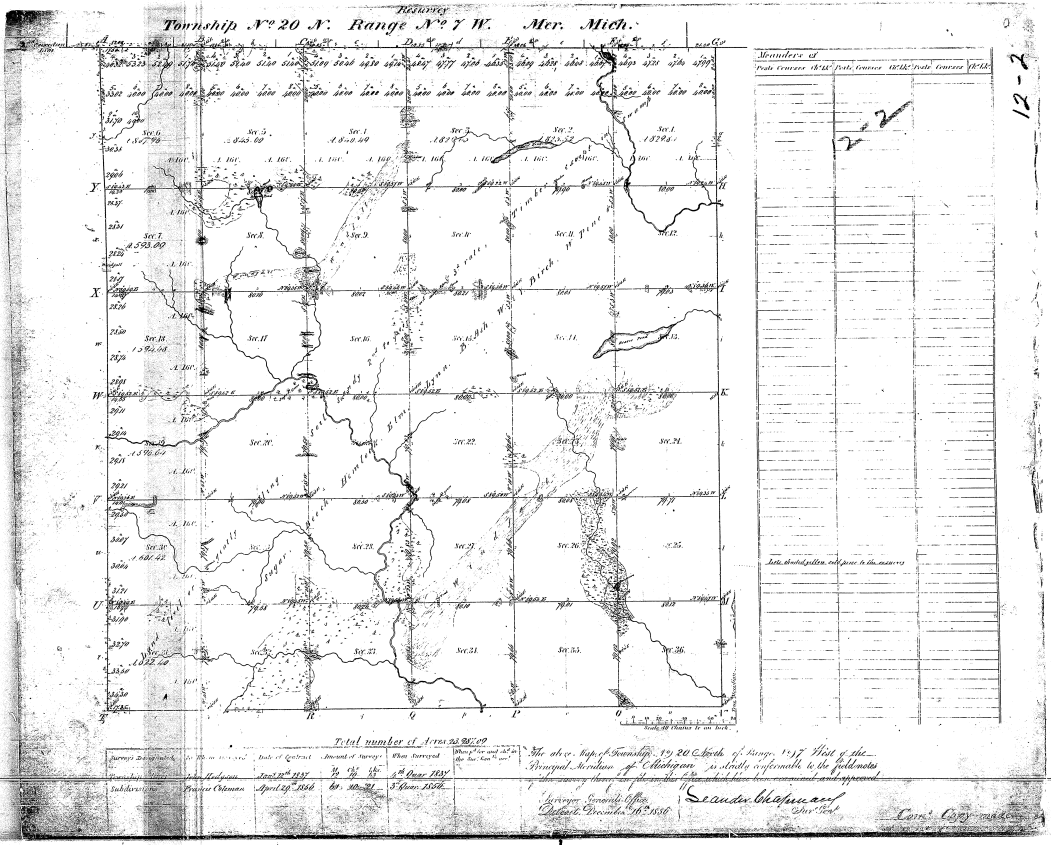
Resurvey
Township Nº 20 N. Range Nº 7 W. Mer. Mich.
Meanders of
Total number of Acres 23,287.09
Date of Contract April 28th 1836
When Surveyed 5th Quar. 1836
The above Map of Township 20 North of Range 7 West of the Principal Meridian in Michigan is strictly conformable to the field notes of the survey thereof returned into this Office, which have been examined and approved.
Surveyor General's Office Detroit December 16th 1836
Alexander Chapman Surv. Genl
Certified Copy made
12-2