


Township N. V North, Range N. III West. Mer. (Min. Ter.)

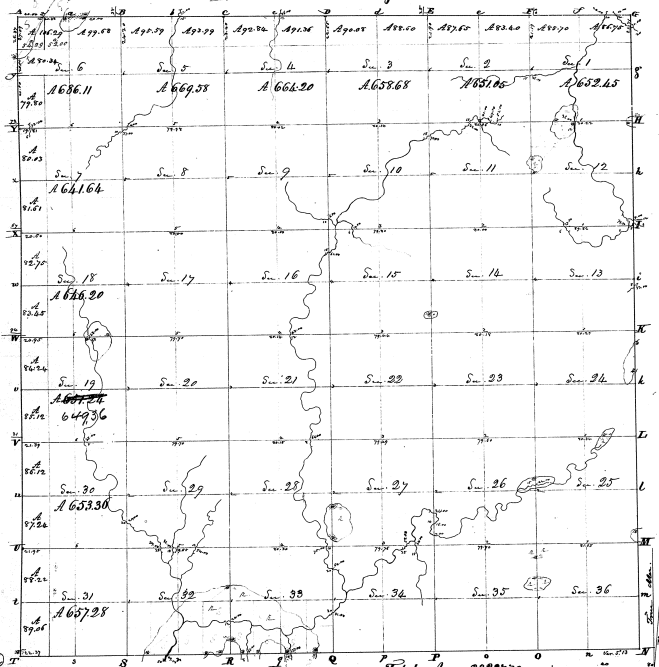

Contract			Date	
Sections	Acres	Sections	Acres	Date

8.2
8.21



