


Township N. VII North, Range N. XIII, West Mer. (Mia. Ter.)

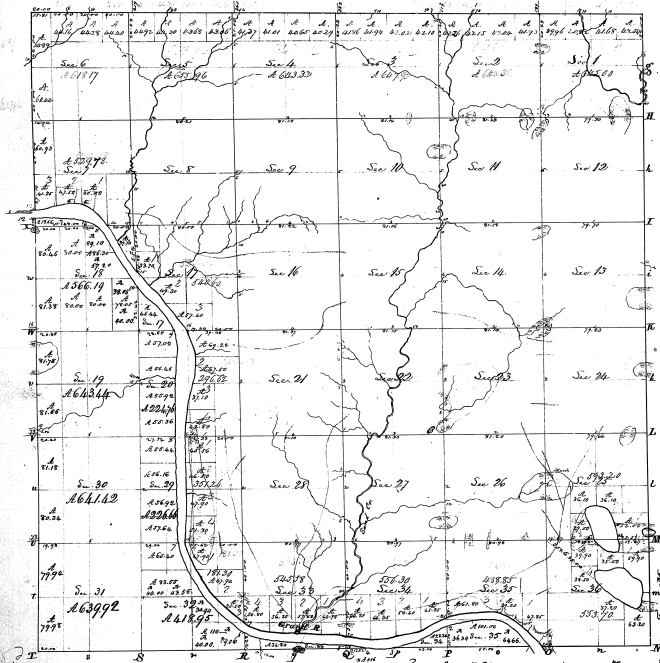

Total Acres, 3621.00

Scale as shown on sheet



Surveyor General's Office
Cincinnati, March 27th 1838.

M. T. Williams
Secy. G. S.

135

8-15



813