Resurvey

Township No. 36 N. Range No. 5 E. Mer. Mich.

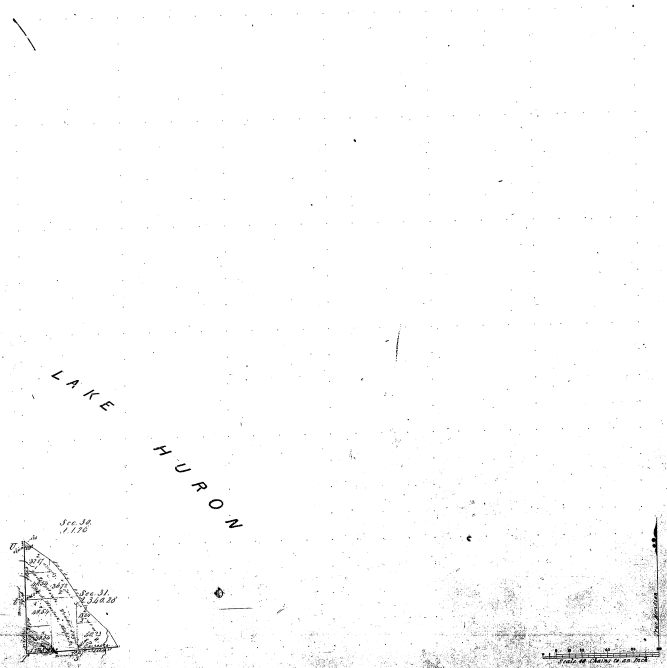

Meanders of								
Posts	Courses	Ch's Lks	Posts	Courses	Ch's Lks	Posts	Courses	Ch's Lks

19-36

Total number of Acres 34.1.54

Surveys Designated	By Whom Surveyed	Date of Contract	Amount of Surveys M. Ch's Lks	When Surveyed	When Charged in the Surv'r Gen'l's acct.
Township Boundary Subdivisions	G. H. Cannon	Oct. 5th 1854	70 27	2nd Quar. 1856	
	G. H. Cannon	Oct. 5th 1854	1 34 80	2nd Quar. 1856	

The above Map of Township No. 36 North of Range No. 5 East of the Principal Meridian of Michigan is hereby conformable to the field notes of the survey thereof on file in this Office which have been examined and approved.

Surveyor General's Office Seander Chapman Surv'r Genl
Detroit September 25 1856

Com'd Copy