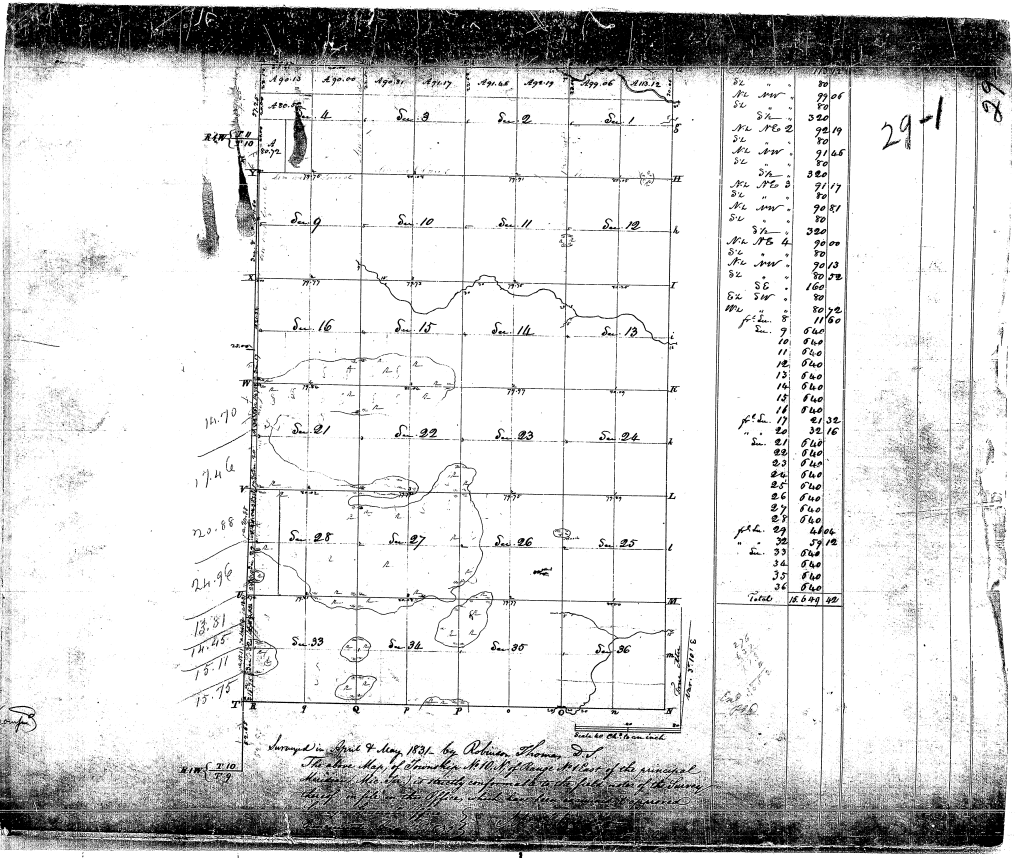

SL	"	80	
NL	NW	77	06
SL	"	80	
	SL	320	
NL	NE 2	92	19
SL	"	80	
NL	NW	91	65
SL	"	80	
	SL	320	
NL	NE 3	91	17
SL	"	80	
NL	NW	90	81
SL	"	80	
	SL	320	
NL	NE 4	90	00
SL	"	80	
NL	NW	90	13
SL	"	80	32
	SE	160	
SL	SW	80	
NL	"	80	72
Fr.	Sec. 8	1160	
Sec.	9	640	
	10	640	
	11	640	
	12	640	
	13	640	
	14	640	
	15	640	
	16	640	
Fr.	Sec. 17	41	32
"	18	32	16
Sec.	21	648	
	22	640	
	23	640	
	24	640	
	25	640	
	26	640	
	27	640	
	28	640	
Fr.	29	640	
"	32	59	12
Sec.	33	640	
	34	640	
	35	640	
	36	640	
Total		15849	92

29-1