57

24-28

24-28

Township N.º XII North, Range N.º V East Mer. (M. Ter.)

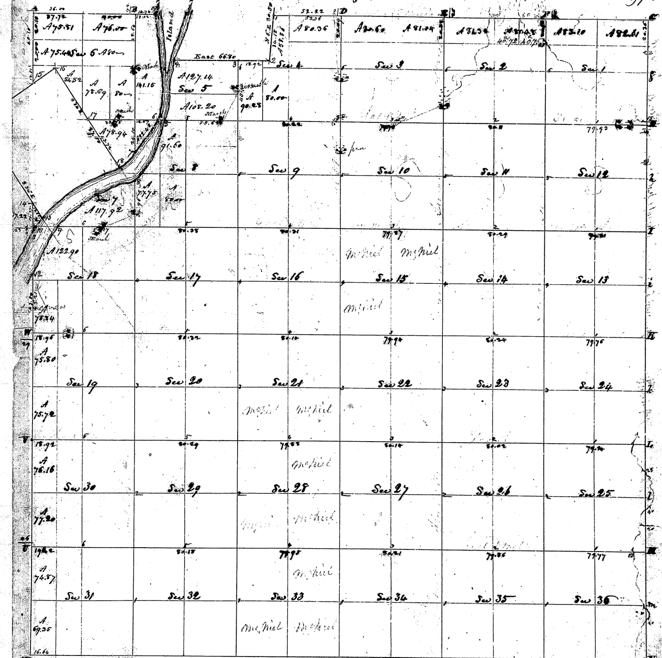

Total Acreage 22.496 98/100

Pursuant to a Contract with and instructions from Edward Tiffin Surveyor General of the United States, bearing date the day of I have admeasured laid out and surveyed the above Township, and do certify that it has such marks and bounds both Natural and Artificial as are represented on said plat and described in the field notes made thereof and returned with this plat into the Surveyor Generals Office. Certified this 22nd day of April 1822

J Wampler D.S.