Township No. 12 N, Range No. 12 E Mer. Mich.

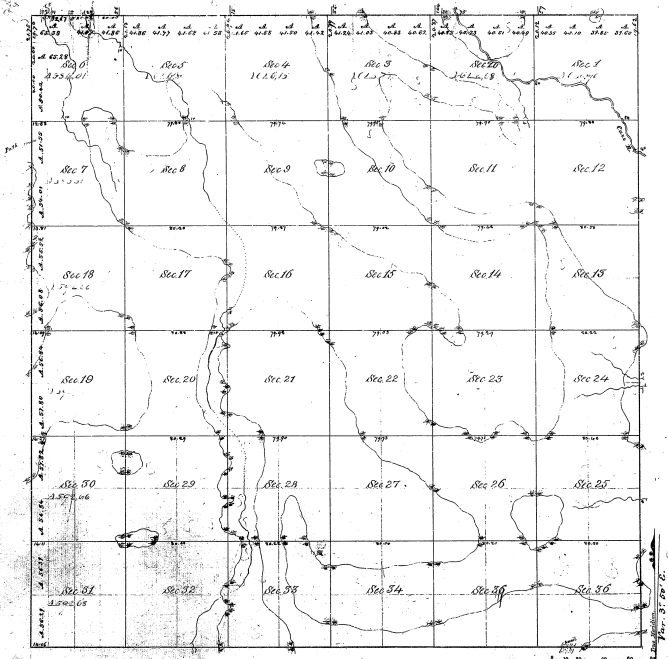

Total number of [illegible] 22,761,50

Surveys Designated	By Whom Surveyed	Date of Contract	Amount of Surveys	When Surveyed	Whole 3rd Ser. and 4th in the Surv. Gen. Ls. acc.
Subdivision.	N. Brock Jun.	11 Aug. 1834	M. 59 Ch. 52 Lk. 57	4th 9th 1834	1 Jr. 1835
[illegible]	[illegible]	22 Nov. 1833	23 67 57	3rd 9th 1834	3 [illegible]

The above Map of Township No. 12 North of Range No. 12 East of the Principal Meridian, Mich. Ter. is strictly conformable to the field notes of the survey thereof on file in this Office, which have been examined and approved.

Surveyor Generals Office,
Cincinnati, Mar. 30. 1835

M. T. Williams
Surv. Genl.

Meanders of

Post	Courses	Ch. Lk.	Posts	Courses	Ch. Lk.	Posts	Courses	Ch. Lk.

25-33

25-33