Township No. 12 N. Range No. 15 E. Mer. Mich.

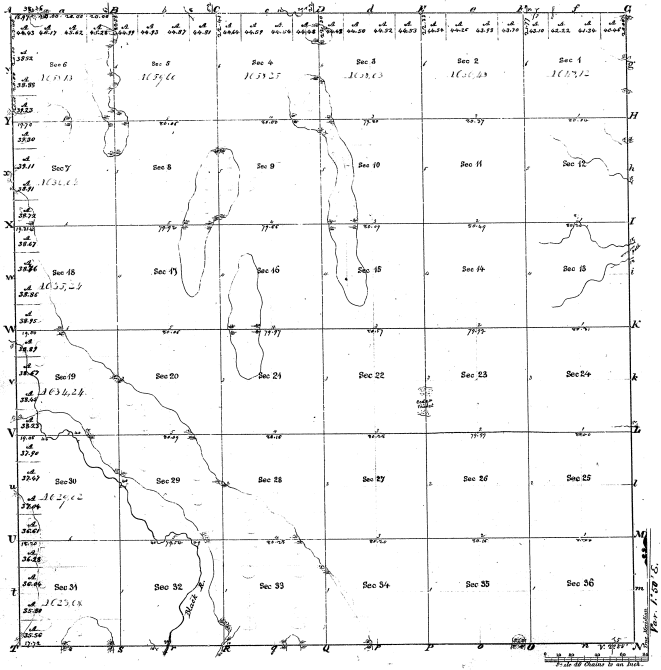

Meanders of								
Posts	Courses	Ch. Lks.	Posts	Courses	Ch. Lks.	Posts	Courses	Ch. Lks.

25-30

Total number of Acres 23,695,53

Surveys Designated	By Whom Surveyed	Date of Contract	Amount of Surveys	When Surveyed	When p.d. for and ch.d in the Sur. Gen.l Ass.t
Subdivision.	N. Brown & Field	11. Aug. 1834	60. 07. 11	4. q.r 1834	1. q.r 1835
Township lines.	Harvey Parke	25th Feb. 1833	23. 79. 48	1st q.r 1834	2. q.r 1834

The above Map of Township No. 12, North, of Range No. 15 East of the Principal Meridian, Mic. Ter. is strictly conformable to the field notes of the survey thereof on file in this Office which have been examined and approved

Surveyor General's Office.
Cincinnati Mar. 30 1835

M. T. Williams
Sur. Gen.l