Township No. 40 N. Range No. 16 W. Mer. Mich.

46-17

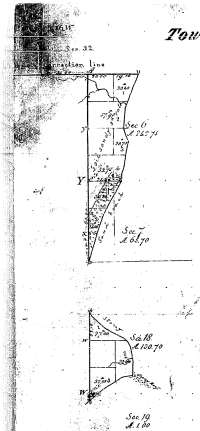

Meanders of

Town	Courses	Dist.	Town	Courses	Dist.	Town	Courses

Total Meanders
181
3 09 40

Trail Meridian.

1 0 1 2 3 4 5 Miles

Scale 40 Chains to an Inch.

Total number of Acres 44016

Surveys Designated.	By Whom Surveyed.	Date of Contract.	Amount of Surveys. M.	Ch.	Lks.	When Surveyed	When Accepted by the Surveyor Genl.
Township lines.	John Burt.	[illegible] 1840				[illegible] 1844	
Subdivisions.	A. Merryweather	Feb 21st 1846	[illegible]	[illegible]	[illegible]	[illegible] 1848	

The above Map of Township No. 40 North of Range No. 16 West of the Principal Meridian, Michigan, is strictly conformable to the field notes of the survey thereof on file in this Office, which have been examined and approved.

Surveyor General's Office, Detroit, April 24th 1849.

Lucius Lyon, Surv. Gen.