Township No. 41 N. Range No. 14 W. Mer: Mich.

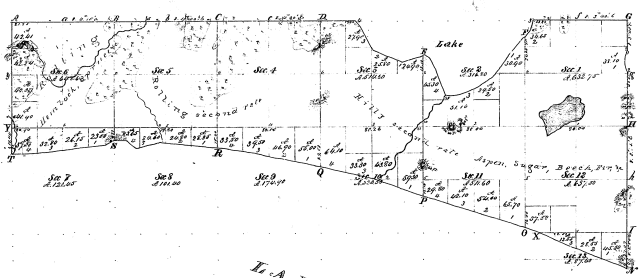

LAKE. MICHIGAN.

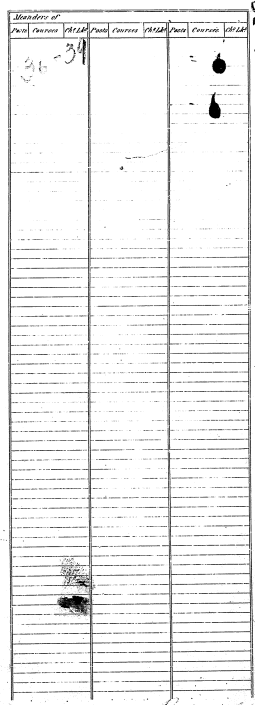

Total number of Acres 5,347.72

Survey Designated.	By Whom Surveyed.	Date of Contract.	Amount of Surveys M. Chs. Lks.	When Surveyed.	When Changed in the Surv't Gen'l's office?
Township lines	John Hunt	Feby 26 1845	22. 65. 52	2nd qr. 1845	
Subdivisions					

The above Map of Township No. 41 North of Range No. 14 West of the Principal Meridian, Mi. is strictly conformable to the field notes of the survey thereof on file in this office and is hereby accepted and approved.

Surveyor Generals Office, Detroit Mich. may 24. 1846

Lucius Lyon, Surv. Genl