Township No. 46 N. Range No. 15 W. Mer: Mich.

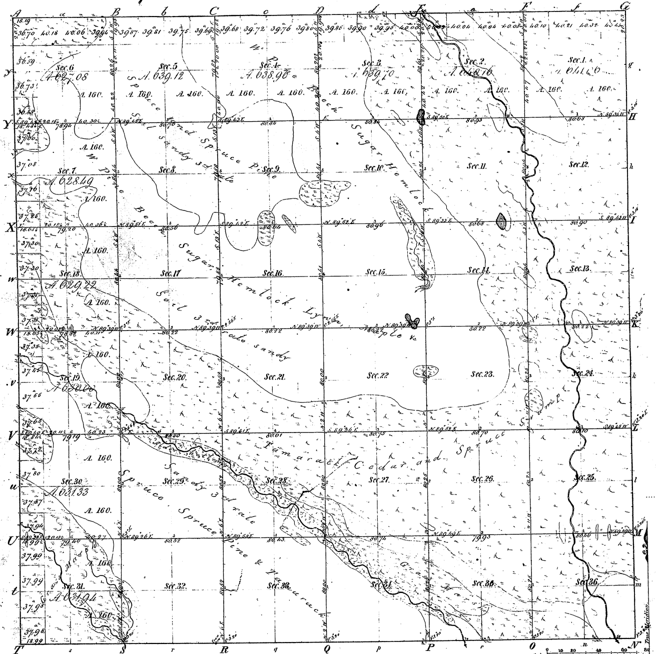

Total number of Acres. 22.971.06

Surveys Designated	By Whom Surveyed	Date of Contract	Amount of Surveys	When Surveyed	When pd. for and chd. in the Sur. Genl's acct.
Township lines	William A. Burt	April 1. 1841	41 Chs. 79 Lks. 22	3rd Quar. 1841	
Subdivisions	Guy H. Carleton	Bond Dec 20. 1850	60. 18. 84	3rd Quar. 1850	

The above Map of Township No. 46 North of Range No. 15 West of the Principal Meridian Michigan is strictly conformable to the field notes of the survey thereof on file in this Office, which have been examined and approved.

Surveyor General's Office,
Detroit September 2 1851

Charles Noble
Sur. Genl.

Meanders of

Posts	Courses	Ch. Lk.	Posts	Courses	Ch. Lk.	Posts	Courses	Ch. Lk.
3 - 17								

36-17