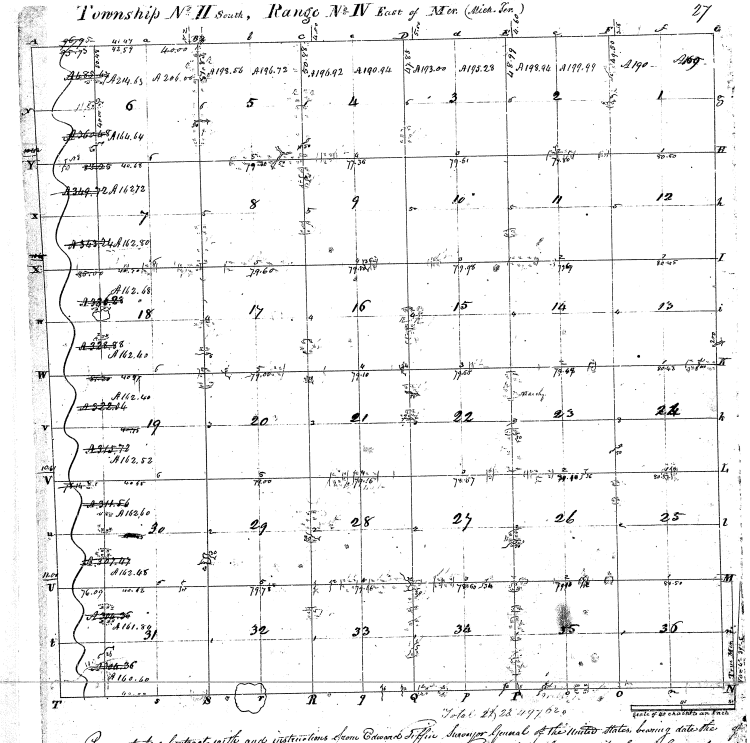
Township No. II South, Range No. IV East of Mer. (Mich. Ter.)
27
30-4
30-8
Pursuant to a contract with said instructions from Edward Tiffin Surveyor General of the United States, bearing date the
day of 1819 I have accurately laid out and surveyed the above described Township &
do hereby certify that the lines on said
plat are correctly represented as run by me in the field, and that the variations
and courses both natural and artificial as are represented on said plat are
correctly noted in the field notes made by me during the progress of the survey
with the plat into the Surveyor Generals office —
Certified this 15th day of September 1819 —