Township N.° III South, Range N.° V East of the Meridian. (Mich. Ter.)

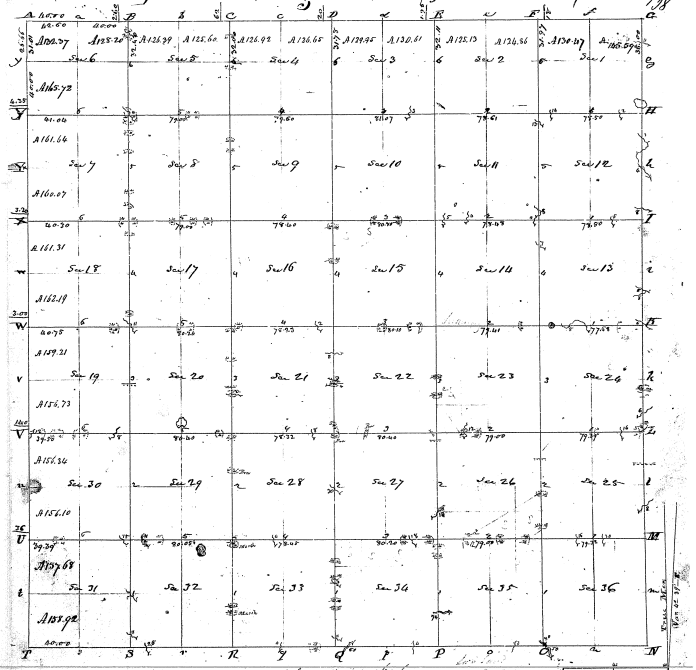

Pursuant to a Contract with said Instructions Jared Edwards Esqr. Surveyor General of the United States, bearing date the day of April 1819. I have actually Laid out and Surveyed the above described Township. I do hereby certify that it has such Marks and bounds both natural and artificial as are represented on said plat and described in the Notes with which this is connected. Also with this plat into the Surveyor Generals Office.

Certified this 15th day of September 1819

J. Wampler D.S.

31-16

31-16