


Township N^o 1 south, Range N^o IX East. (Archieve Co.)

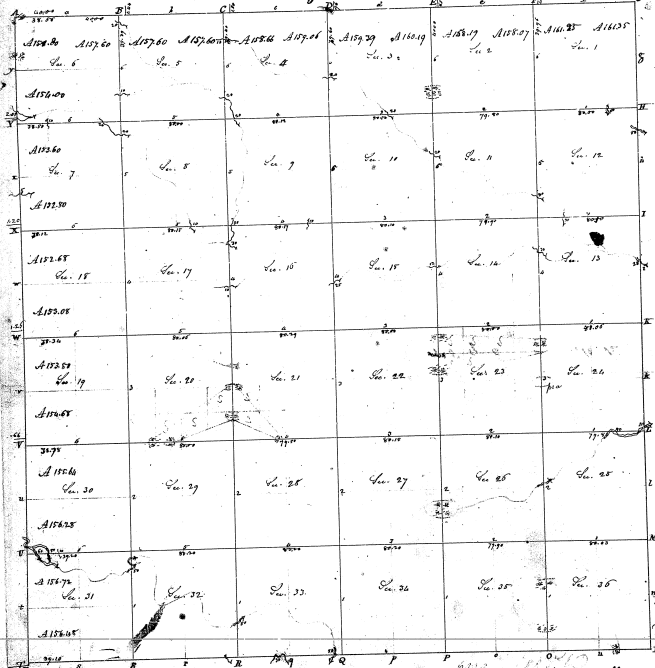

31-2

31-2


