Islands in Thorn Apple River

Township N.o 4 N. Range N.o 10 W. Mer. Mich.

7-27

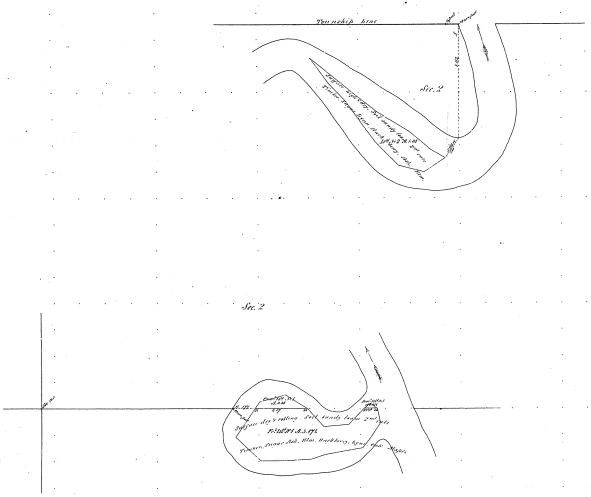

Meandres of							
Posts	Courses	Ch & Lks	Posts	Courses	Ch & Lks	Posts	Courses	Ch & Lks

Scale 4 Chains to an Inch.

Total number of Acres

Survey Designated.	By Whom Surveyed.	Date of Contract.	Amount of Purchase M. Ch.s	Lks	When Surveyed.	When Changed in the Gen.l Land Office
Township lines.						
Subdivisions.	Thos. Whitsley	September 1st 1856			1856	

The above Map of Township No. 4 North of Range No. 10 West of the Principal Meridian, of Michigan, is strictly conformable to the field notes of the survey thereof on file in this Office, which have been examined and approved.

Surveyor Generals Office, Detroit, April 18th 1857 } Ned Tomlinson Surv.r Genl.