Township No. 9 North Range No. 1 West of the Michigan Meridian

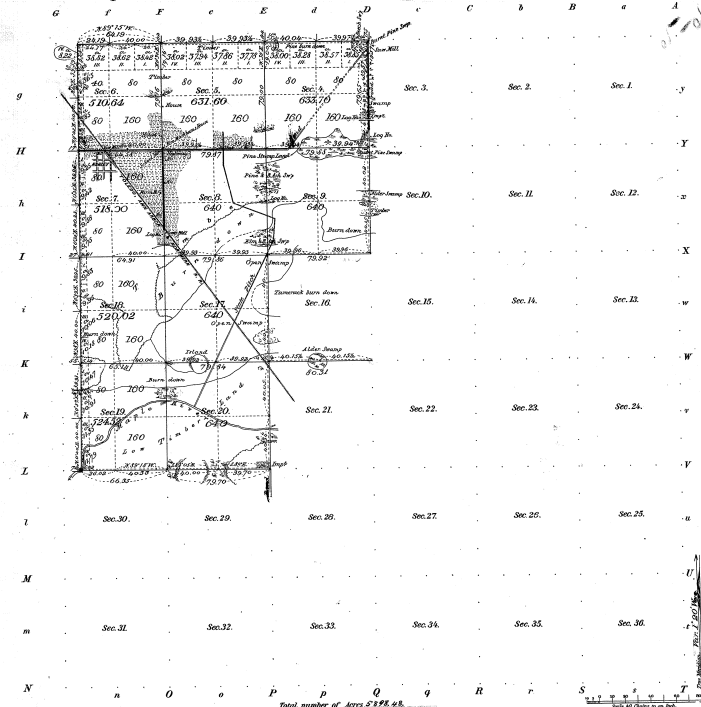

Total number of Acres 5898.40.

Meanders of							
Posts	Courses	Ch. Lks.	Posts	Courses	Ch. Lks.	Posts	Courses	Ch. Lks.

Survey Designated	By Whom Surveyed	Date of Original Appointment	Amount of Survey M. Ch. Lks.	When Surveyed	Rem. Indicated.
Township lines (revised)	Miles W. Bullock	Dec. 17th. 1853.		Jan. 29th. Feb. 17th. 54	
Subdivisions (revised)	Miles W. Bullock	Do.		Do.	
Subdivisions (new lines run)	Miles W. Bullock	Do.		Do.	

The above Map of Township No. 9 North of Range No. 1 West of the Michigan Meridian, State of Michigan is strictly conformable to the field notes of the survey thereof on file in this Office, which have been examined and approved.

General Land Office,
Washington D.C. April 28th 1854.

N. C. Wright
Commissioner.

Surveyor General of Michigan.