Islands in Grand River

Township No. 6 N. Range No. 8 W. **Mer. Mich.**

6-17

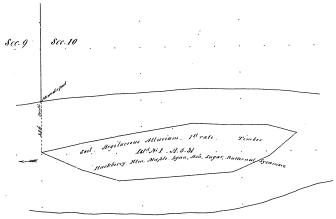

Scale 4 Chains to an Inch.

Meanders of								
Posts	Courses	Dist. Lks	Posts	Courses	Dist. Lks	Posts	Courses	Dist. Lks

Total number of acres 331

Surveys Designated.	By Whom Surveyed.	Date of Contract.	Amount of Surveys. M. Ch. Lks.	When Surveyed.	When Charged in the Surr. Genl's orr.
Township lines.					
Subdivisions.	Thos. Wheatley	Instructions May 24th 1854		2d Quar. 1855	

The above, Map of Township No. 6 North of Range No. 8 West of the Principal Meridian, of Michigan is strictly conformable to the field notes of the survey thereof on file in this Office, which have been examined and approved.

Surveyor Generals Office. Detroit, June 2d. 1855.

Saml. Ch. Ashmun Surv. Genl.

Corr. Copy made
Reg. Copy made