


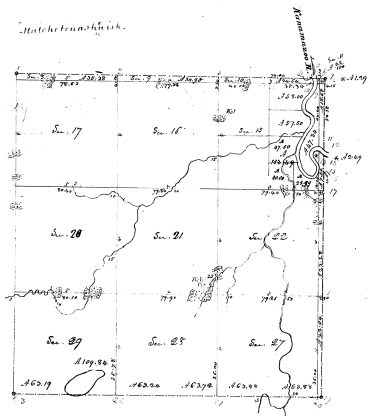






2-5

2-5


T. 2 S. R. 11 W. Mich

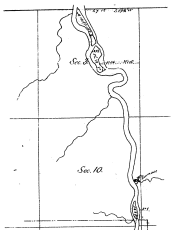


The above diagram of islands in the Kalamazoo  
 River in T. 2 S. R. 11 W. is hereby confirmed with the field  
 notes of the same on file in this office  
 Surveyor General's Office  
 Detroit, August 29 1870  
 Charles H. Hill  
 Surveyor General

2-5

2-5 ③