Resurvey

Township No. 31 N. Range No. 11 W. Mer. Mich.

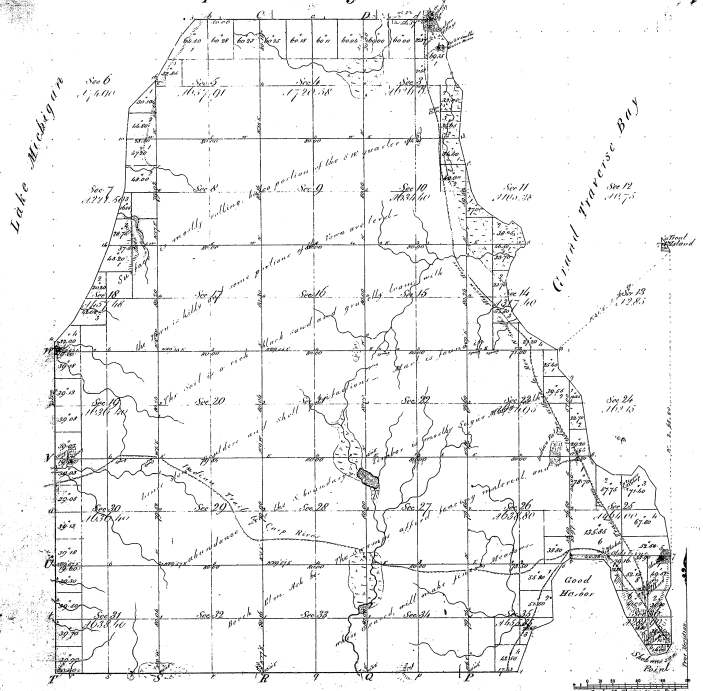

Meanders of								
Twp.	Range	Sec.	Lat.	Twp.	Range	Sec.	Lat.	