59

31-24

31-24

Township No. V South, Range No. VII East of the Mer. (Mich. Ter.)

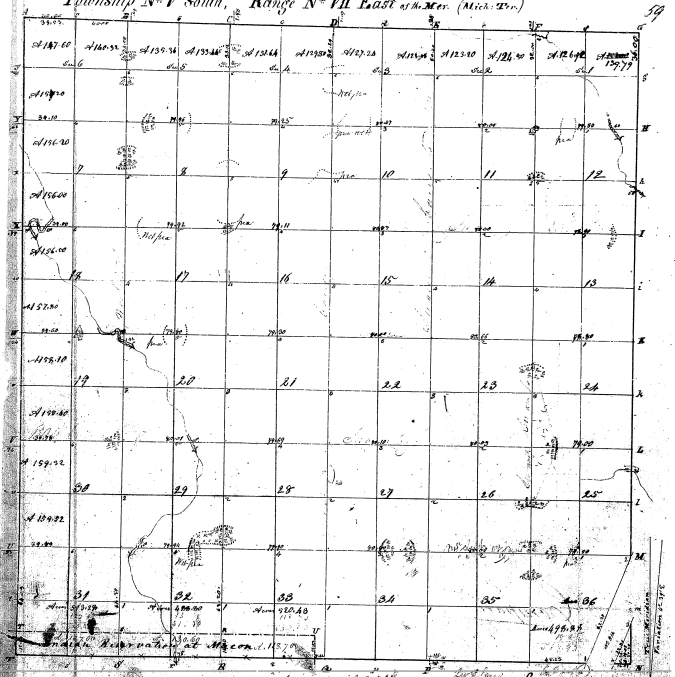

Pursuant to a contract with and instructions from Edward Tiffin Surveyor General of the United States, bearing date the eighteenth day of June aforesaid I have actually surveyed the lines of this township, and do hereby certify that the lines thereof are correctly represented on this plat, and conformable to the field notes made thereof, and that the subdivisions of sections, as represented on this plat, are conformable to the laws of the United States made thereof, and to the instructions of the Surveyor General.

Detroit this 20th day of September 1819 — Joseph Sheldon