Michigan

Township No. 9 N., Range No. 14 West Mer. (Mich.)

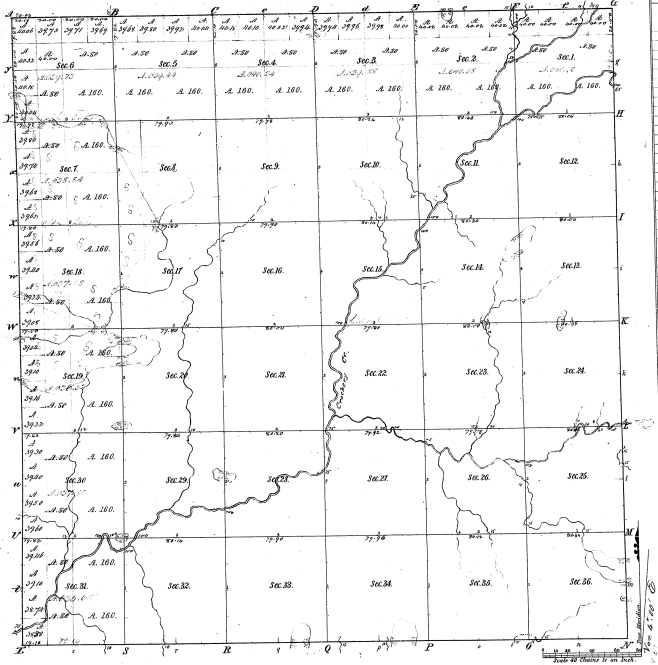

Meanders of						
Posts	Courses	Dist.	Posts	Courses	Dist.	Posts	Courses	Dist.

8.16

Survey of the meanders of the ... Creek

9-8

Total number of Acres 23,073.44

Surveys Designated	By Whom Surveyed	Date of Contract	Amount of Surveys	When Surveyed	When approved and by the Surveyor Gen.l	When received
Township lines	A. Dexter & Wm. M. Ely	31 Dec. 1824	42 - 79 - 42	2nd qr. 1827	3rd qr. 1828	
Subdivisions	Silas Merrill	4 Aug. 1824	39 - 78 - 47	2nd qr. 1827	4th qr. 1827	

The above Map of Township No. 9 North of Range No. 14 West of the Principal Meridian, Michigan is strictly conformable to the field notes of the survey thereof on file in this Office, which have been examined and approved.

Surveyor Generals Office
Cincinnati, Dec. 28 1827

S. S. Lee Surv. Gen.l