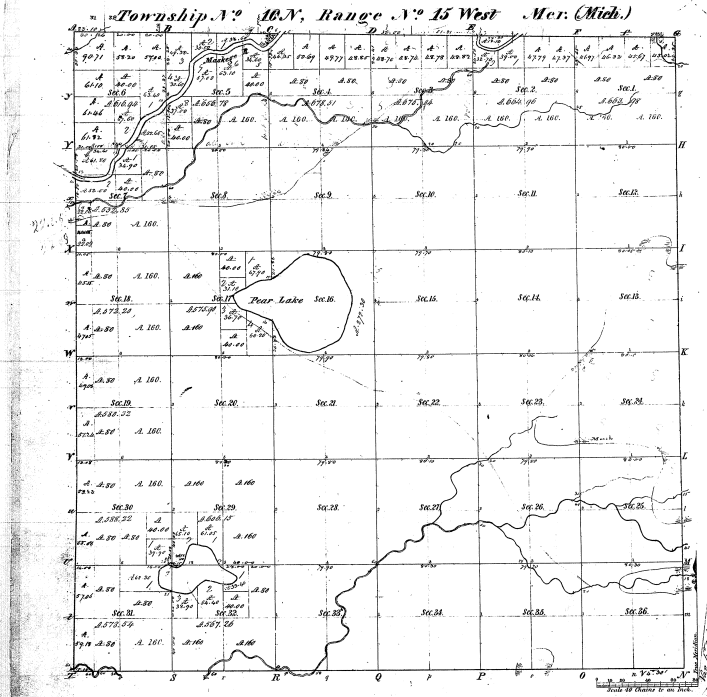

Meanders of Muskegon River 2d Sect.

Posts	Courses	Dist.s	Posts	Courses	Dist.s	Posts	Courses	Dist.s
Muskegon River.			Lake in Sec 16 & 17					
1st R Bank up Stream.			18	S 77 W	28.00			
72	S 25 E	7.50		S 26 E	13.00			
	S 78 E	22.00		S 63 E	22.00			
	S 30 E	8.00	19	S 87 E	8.00			
	S 78 E	8.00		N 78 E	18.00			
	S 26 E	8.00		N 26 E	22.00			
	S 56 E	8.00		N 56 E	20.50			
71	S 82 E	8.00		N 82 E	24.00			
	N 80 E	8.00		N 80 E	22.50			
	N 72 E	18.00		N 72 E	23.50			
70	N 56 E	8.00	20	N 57 E	20.00			
	N 78 E	8.00						
	N 46 E	18.00	Lake in Sec 20 & 21					
	N 26 E	12.00	22	N 77 W	1.50			
	N 61 E	7.00	21	N 78 W	1.50			
	N 83 E	13.00		S 60 W	8.50			
	S 72 E	6.00		S 26 W	10.00			
	S 46 E	8.00		S 56 W	10.00			
	S 26 E	12.00		S 82 W	10.00			
	S 12 E	12.00		S 74 W	18.00			
69	S 26 E	8.00		S 52 W	7.00			
	S 45 E	8.00	17	S 26 W	17.50			
	S 72 E	12.00		S 57 W	20.00			
				S 77 W	17.00			
Right Bank down Stream			18	S 41 W	15.00			
16	S 26 E	8.00		S 82 W	3.00			
15	S 84 E	4.00	19	S 41 W	3.50			
	S 64 W	8.00	22	N 35 W	1.00			
	S 26 W	8.00						
	S 83 W	15.00						
	S 56 W	8.00						
	S 82 W	8.00						
	S 72 W	5.00						
	N 57 W	5.00						
	N 72 W	8.00						
	N 82 W	7.00						
	N 56 W	7.50						
	N 26 W	12.00						
	N 63 W	3.00						
14	S 64 W	10.50						
	S 73 W	8.00						
	S 82 W	8.00						
	S 72 W	13.50						
13	S 82 W	8.50						
	S 72 W	7.00						
	S 64 W	8.00						
	S 72 W	22.00						
12	S 82 W	2.50						
8 Section 2								
Left Bank up Stream								
9	N 10 E	6.00						
	N 49 E	6.50						
	N 72 E	9.00						
	N 26 E	11.50						
1	N 16 E	12.00						
Right Bank up Stream								
2	N 63 W	20.00						
	N 72 W	10.00						
	N 82 W	3.00						
3	N 72 E	5.50						

Surveys Designated	By Whom Surveyed	Date of Contract	Amount of Surveys	When Surveyed	When the last sub.ns to the Surv.r Gen.l was rec.d
Township lines	N. J. Beckwith	Sept. 21 1836	23 78 24	2.d— 1837	3.d— 1838
Subdivisions	John Mullett	Aug.st 12 1837	71 71 91	2.d— 1837	4.th— 1837

Total number of Acres 23,284.95

The above Map of Township N.º 16 N. of Range N.º 15 W. of the Principal Meridian in the State of Mich.n is strictly conformable to the field notes of the survey thereof on file in this Office, which have been examined and approved.

Surveyor Generals Office, Detroit Dec.r 25.th 1838

Surv.r Gen.l