


Township N^o 12 N. Range N^o 17 West Mer. (Mich.)

9-19

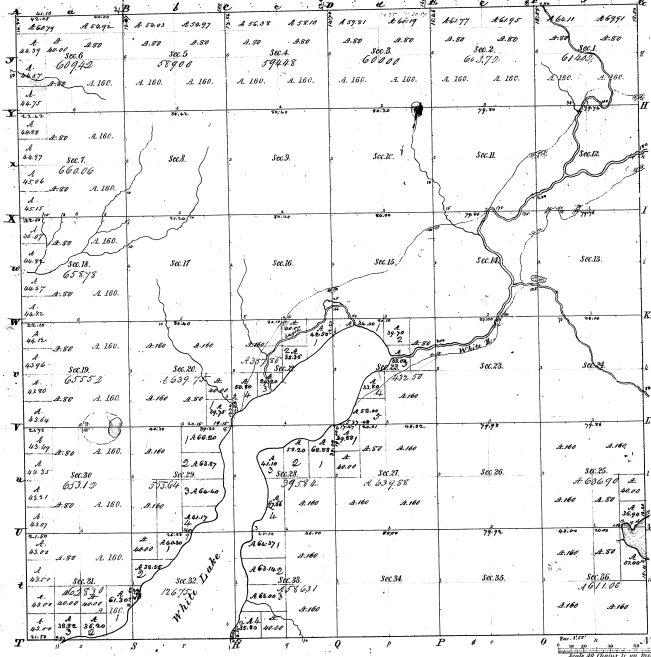

Masters of Tracts			
Post Course	Acres	Post Course	Acres

9-19

Survey designated	By whom Surveyed	Date of Contract	Amount of Survey	When Surveyed	Amount of Survey
Township 12 N. Range 17 W. Subdivisions	Wm. Whittier & Co.	Feb. 17, 1829	36 04 16	3 29 1829	36 04 16
	Wm. Under	" 28	66 52 25	1 st 1828, 1 st 9-1829	66 52 25

Total number of acres 21665.50

The above map of Township N^o 12 N. Range N^o 17 West Michigan is truly and correctly made, & the field notes of the survey thereon are in the office, which have been examined and approved.
Surveyor General's Office
Ann Arbor, Feb. 27, 1829
C. P. Lawrence Surveyor General