Township No. 25. N. Range No. 3. E. Mer. Mich.

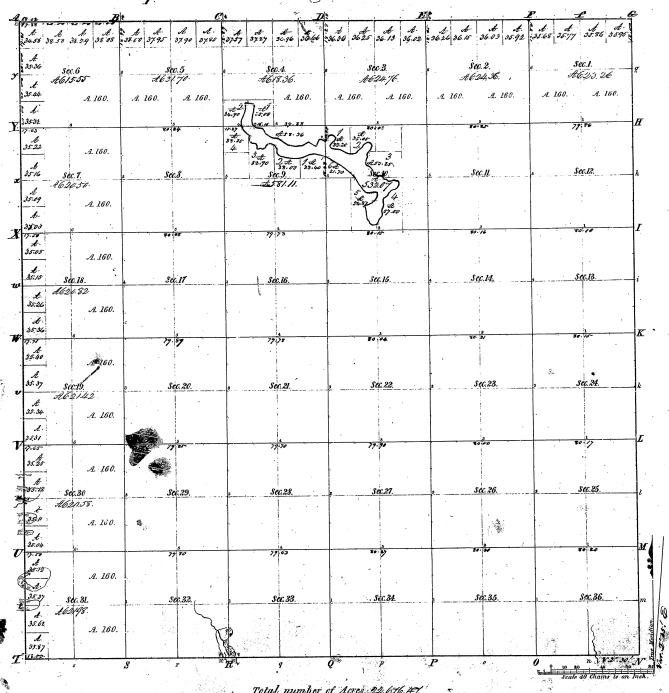

Total number of Acres 22 676.27

Surveys Designated	By Whom Surveyed	Date of Contract	Amount of Surveys	When Surveyed	When Plat for and est.d in Ac. Sur.r Gen.l was rec.d
Township lines	[illegible]	[illegible]	18 00	1839	
Subdivisions	William H. Brown	May 31st 1839	22 06 00	Dec.r 1839	5 Dec.r 1840

The above Map of Township No. 25 North of Range No. 3 East of the Principal Meridian Michigan is strictly conformable to the field notes of the survey returned to this Office, which have been examined and approved.

Surveyor Generals Office
Cincinnati, April 25th 1846

C. L. Ross Surv.r Genl.


	Point	Courses	(N.E.)	Point	Courses	(N.E.)	Point	Courses	(N.E.)
2	1	N 17 W	3.71	2	S 84 W	2.47			
	2	N 25 W	2.26	3	S 72 W	1.16			
	3	N 30 W	1.32	4	S 74 W	4.64			
	4	N 38 W	3.31	5	S 88 W	4.53			
	5	N 84 W	7.32	6	S 80 W	2.15			
	6	N 50 W	4.15	7	S 45 W	3.10			
	7	N 40 W	7.07	8	S 18 W	6.20			
	8	N 27 W	4.32	9	S 37 W	4.32			
	9	N 30 W	1.96	10	S 28 W	3.99			
	10	N 40 W	1.96	11	S 46 W	2.30			
	11	N 28 W	2.53	12	S 43 W	2.27			
	12	N 30 W	1.35	13	S 22 W	1.27			
	13	N 47 W	4.37	14	S 34 W	2.73			
	14	N 40 W	3.82	15	S 24 W	2.79			
	15	N 28 W	2.51	16	S 38 W	1.13			
3	16	N 24 W	1.88	17	S 60 W	3.30			
	17	N 30 W	2.33	18	S 75 W	2.42			
	18	N 37 W	4.33	19	S 86 W	1.16			
	19	N 8 W	9.20	20	S 70 W	4.54			
	20	N 37 W	5.38	21	S 70 W	5.23			
	21	N 45 W	5.73	22	S 74 W	2.78			
	22	N 47 W	4.60	23	S 80 W	3.96			
4	23	N 45 W	1.27	24	S 76 W	1.36			
	24	N 46 W	2.79	25	S 74 W	1.57			
	25	N 46 W	2.19	26	S 39 W	1.59			
	26	N 45 W	1.76	27	S 37 W	1.67			
	27	N 50 W	2.18	28	S 27 W	3.35			
	28	N 47 W	1.83	29	S 37 W	2.00			
	29	N 50 W	2.84	30	S 38 W	1.02			
	30	N 51 W	2.29	31	S 38 W	1.03			
	31	N 54 W	1.72	32	S 40 W	1.21			
	32	N 47 W	1.90	33	S 38 W	1.59			
	33	N 50 W	3.26	34	S 39 W	3.17			
	34	N 54 W	1.03	35	S 37 W	0.55			
	35	N 60 W	3.32	36	S 37 W	1.03			
	36	N 60 W	0.73	37	S 40 W	1.11			

21-22

21-22