Township No. 32 N. Range No. 1 W. Mer. Mich.

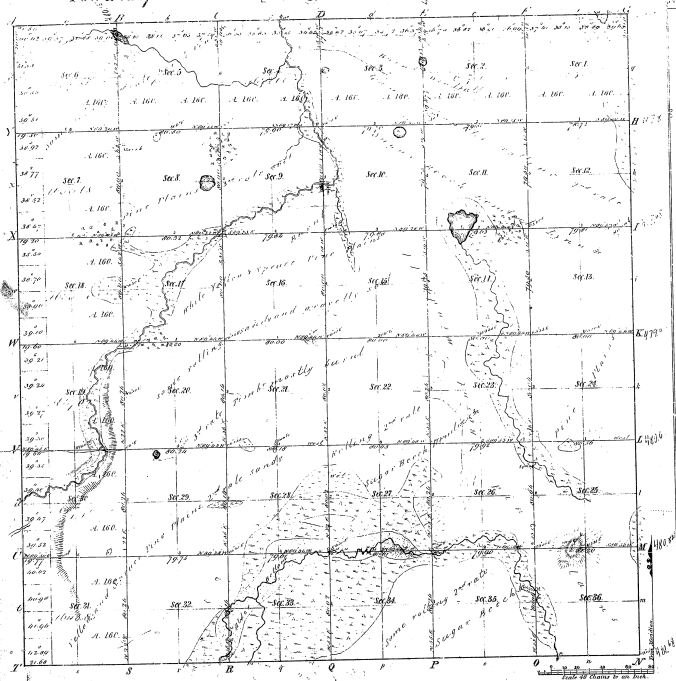

Meanders of

North & South	East & West	North & South	East & West	North & South	East & West	North & South	East & West

18-21

Total number of Acres 22,614.65

Surveys Designated	By Whom Surveyed	Date of Contract	Commencement of Surveys	When Surveyed	When 1st and 2d in the Sec. Sec. 4th
Township lines	John Mullett	Jan 15 1840	M. Ch. Lks. 24 00	1st 1840	
Subdivisions	Wm Burt	Apr. 20 1850	19	1850	

The above Map of Township No. 32 N. of Range No. 1 W. of the Prin. Meridian Michigan is strictly conformable to the field notes of the surveys thereof on file in this Office, which have been examined and approved.

Surveyor General's Office,
Detroit Mich. 22 1850

Charles Wells Surv. Genl.