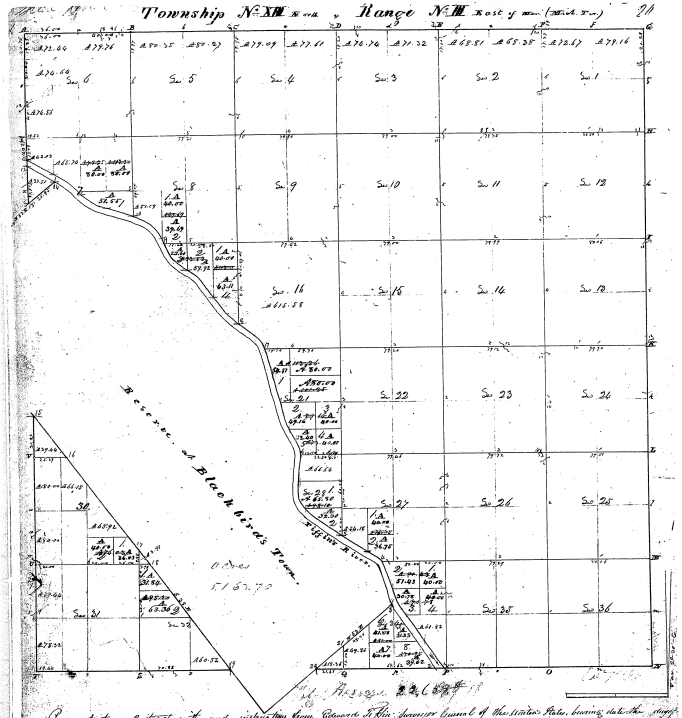

Pursuant to a Contract with and instructions from Edward S. Ellis Surveyor General of the United States, bearing date the [illegible] day of [illegible] I have caused the above delineated township, and do certify that the lines, distances, boundaries, both meandered and subdivisional as are represented on said plat were established in the field, and made thereof and returned with the field notes to this Surveyor General's Office — Certified the 20th day of April 1822.

J. H. Wampler D. S.