Township No. XII North, Range No. IV East Mer. (M. Tin.)

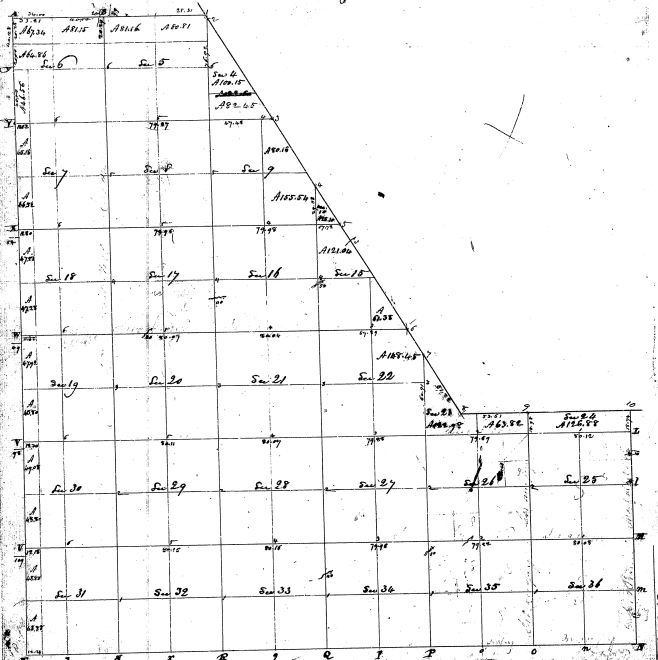

Pursuant to a Contract with and instructions from Surveyor General of the United States bearing date the day of I have commenced and have completed the above Township and do certify that the work has been done in the manner and in conformity with the Instructions and Contracts under which it was performed and that the plat of the same now returned is the original plat of the same as it was established and surveyed on the ground by me and that the same is correct and true to the best of my knowledge and belief.

Certified this 22nd day of May 1822 — H. Kempler D.S.