Township N. V south, Range N. IX west. (Wind. Sr.)

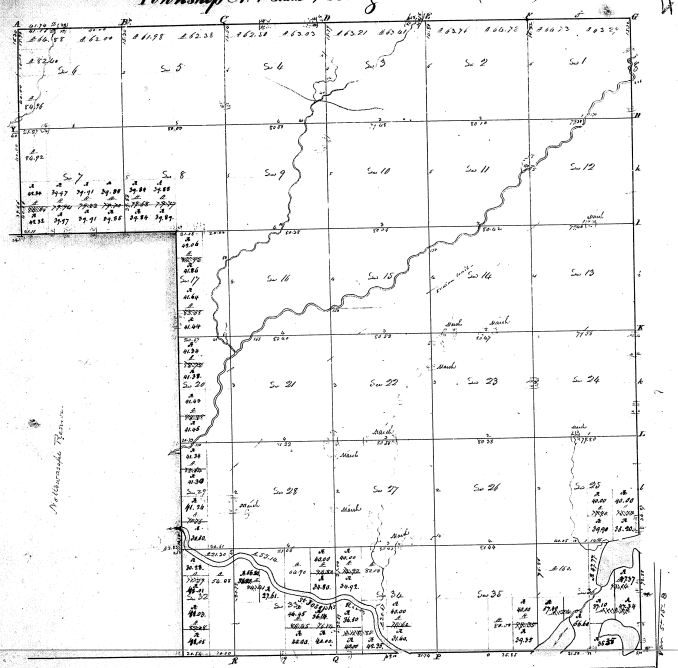
Sec 6
Sec 5
Sec 4
Sec 3
Sec 2
Sec 1
Sec 7
Sec 8
Sec 9
Sec 10
Sec 11
Sec 12
Sec 17
Sec 16
Sec 15
Sec 14
Sec 13
Sec 21
Sec 22
Sec 23
Sec 24
Sec 28
Sec 27
Sec 26
Sec 25
Sec 34
Sec 35
Sec 36
Sec 31
Sec 32
Sec 33
Sec 30
Sec 29