Township No. 38. Range No. 13 W. Mer. Mich

Islands in St. Josephs River.

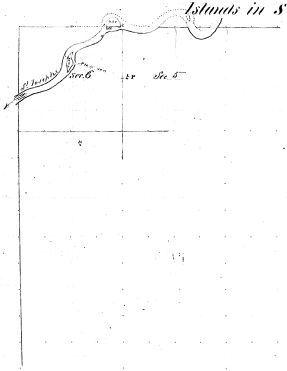

Meanders of								
Posts	Courses	Dist. Lks.	Posts	Courses	Dist. Lks.	Posts	Courses	Dist. Lks.

Scale 20 Chains to an Inch

Total number of Acres 3.15

Surveys Designated.	By Whom Surveyed.	Date of Contract	Amount of Surveys M.	Rd.	Lks.	When Surveyed.	When Charged in the Surr. Gen.l's ent.s
Township lines.							
Meanders of Islands. Subdivisions.	Frank Cheesebrough	Oct. 11th 1845	1.	00	92	Aug. 1845	

The above Meanders in the St Joseph's River in Township No. 38 S. of Range No. 13 West of the Principal Meridian Michigan is strictly conformable to the field notes of the survey thereof on file in this Office, which have been examined and approved.

Surveyor General's Office,
Detroit Mich. 17th 1846

Lucius Lyons, Surv.r Genl