31-16

Township No. III South, Range No. V East of the Meridian. (Mich. Ter.) 38

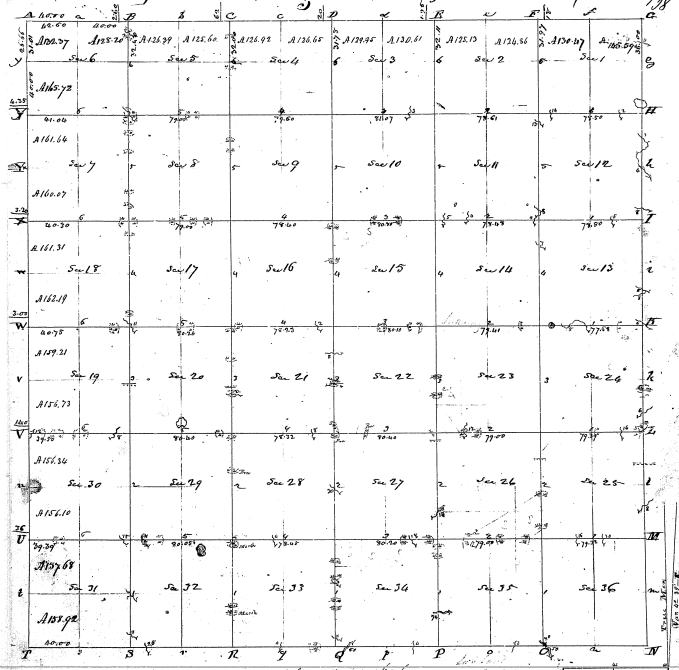

Pursuant to a contract with and instructions from Edward Tiffin Surveyor General of the United States, bearing date the day of April 1819 I have actually laid out and surveyed the above described Township. I do hereby certify that it has been so marked and bounded both natural and artificial as are represented on and by plat and described in the field notes made thereof and agreeable with the plat into the Surveyor General's Office —

Certified this 15th day of September 1819

J. Wampler D.S.