Re survey

Township No. 26 N. Range No. 6 W. Mer. Mich.

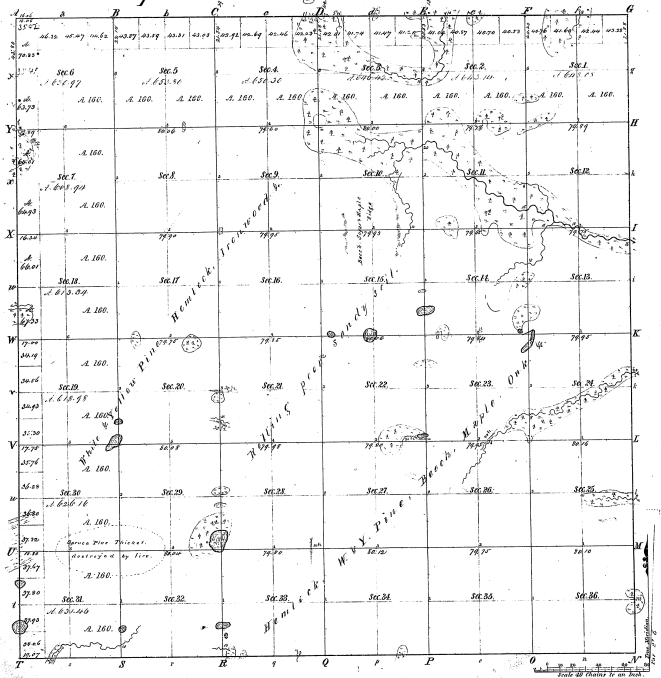

Meanders of							
Poste	Courses	&c. &c.	Poste	Courses	&c. &c.	Poste	Courses &c. &c.

22-18

Total number of Acres. 22971.50

Surveys Designated	By Whom Surveyed	Date of Contract	Amount of Surveys M. Ch. Lks.	When Surveyed	When & to whom the Surr. Gen.l was ...
Township lines	Thomas McCracken	July 20. 1827		1828	
Subdivisions	Joel H. Mullett	June 14. 1836	71. 25	1846	

The above Map of Township No. 26 North of Range No. 6 East of the Principal Meridian Michigan, is strictly conformable to the field notes of the survey thereof on file in this Office, which have been examined and approved.

Surveyor Generals Office.
Detroit, Aug.st 1. 1846.

Lucius Lyon
Surr. Gen.l