Resurvey

Township N.° 46 N. Range N.° 19 W. Mer. Mich.

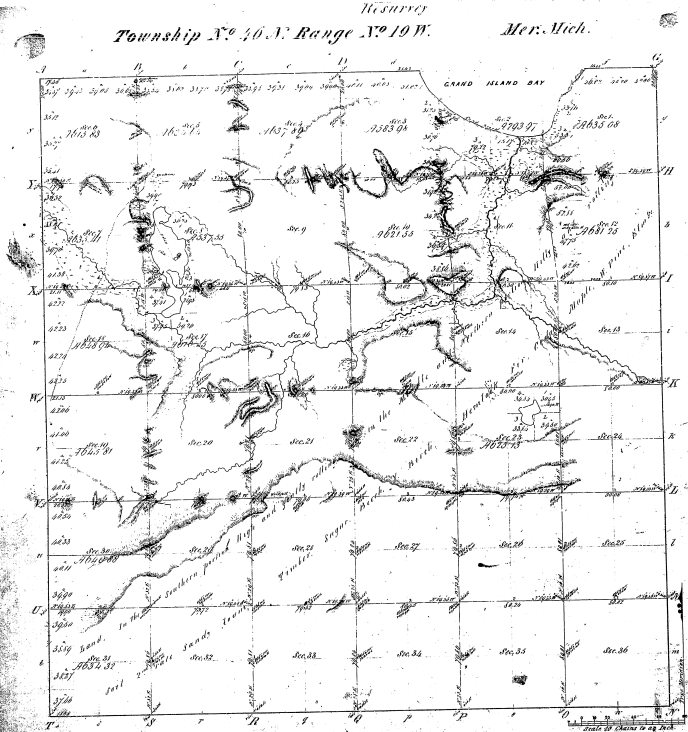

Total number of Acres 29,485.78

Surveys Designated.	By Whom Surveyed.	Date of Contract.	Amount of Surveys. M. Ch.'s Lks.	When Surveyed.	When Changed to the Surv.ed and acc.d
Township lines	[illegible]	[illegible]	[illegible]	2d Quar. 1856	
Subdivisions	A. M. Steele	April 28th 1855	185 [illegible] 07	2d Quar. 1856	

The above Plats of Township 46 N. of Range 19 W. of the Principal Meridian of Michigan is strictly conformable to the field notes of the survey thereof returned to this Office, and have been approved & accepted.

Surveyor General's Office, Detroit, April 11th 1856. Sealander Chapman & Co

Boundaries of

Parcel	Courses	Chs Lks	Parcel	Courses	Chs Lks	Parcel	Courses	Chs Lks

Islands Con. 16.4.4. 16.16.

37-15