Resurvey

Township No. 47 N. Range No. 19 W. Mer. Mich.

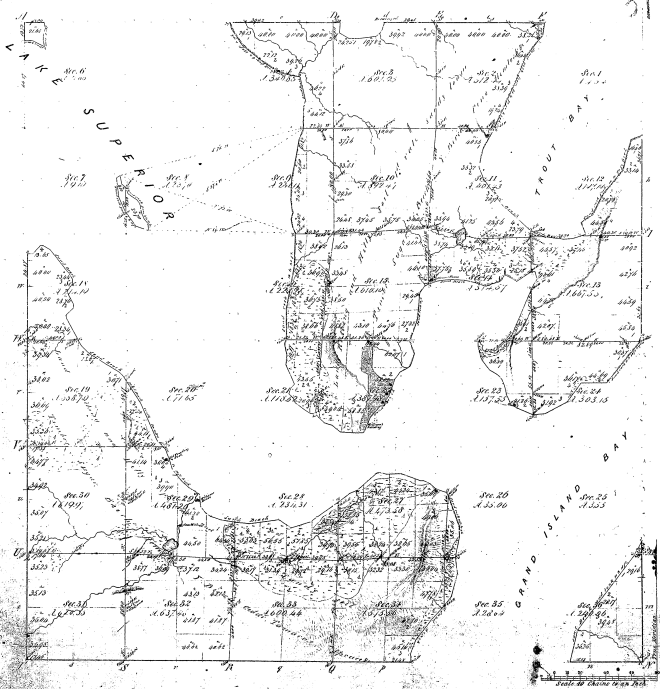

Scale 40 Chains to an Inch.

Total number of Acres 18,581.47

Surveys Suspended	By Whom Surveyed	Date of Contract	Amount of Surveys M.	Ch.	Lks.	When Surveyed	When Charged to the Surveyor
Township Lines	Sam'l Ward	April 1st 1847	7	36	42	3d Quar. 1847	
Subdivisions	Eli H. Adkins	April 8th 1847	156	00	78	3 Quar. 1847	

The above Map of Township No. 47 N. of Range No. 19 W. of the Principal Meridian in Michigan is faithfully compiled from the field notes.

Surveyor General's Office, Detroit, Mich. Nov. 8, 1848. Edmund Christmas Asst. Engr.