36-10

Township No. 48 N Range No. 14 W. Mer. Mich.

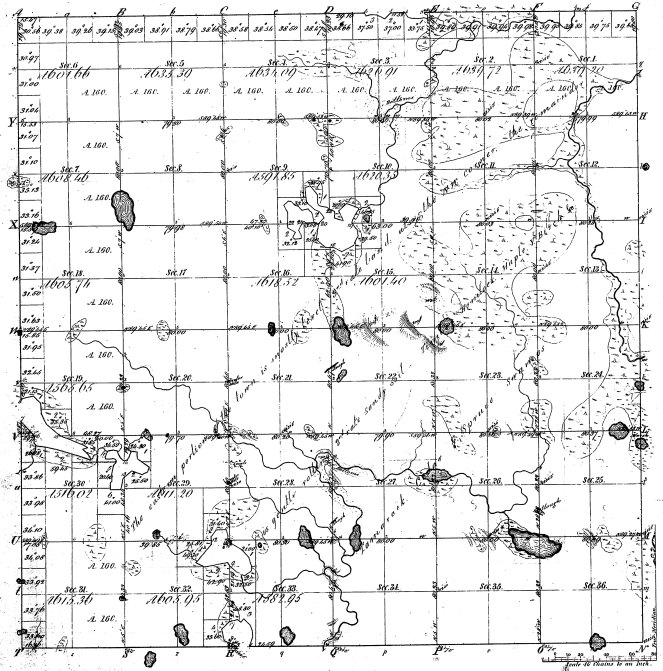

Total number of Acres 23,440.62

Surveys Designated	By Whom Surveyed	Date of Contract	Amount of Surveys	When Surveyed	When & to whom the Surv. Gen.l was
Township lines	William A Reed	April 1st 1851	46 46 46	3rd Quar. 1851	
Subdivisions	Geo. E. Davis	April 9 1851	22. 22. 19	3rd Quar. 1851	

The above Map of Township No. 48 North of Range No. 14 West of the Principal Meridian Michigan is strictly conformable to the field notes of the survey thereof on file in this Office, which have been examined and approved.

Surveyor Generals Office:
Detroit May 19. 1852

Charles Noble
Surv.r Gen.l

Meanders of

Posts	Courses	Chs.	Lks.	Posts	Courses	Chs.	Lks.	Posts	Courses	Chs.	Lks.
36-10											

Meanders
Gen. Jas. Cog. Ck.

Copy inside