Township No. 48 N. Range No. 17 W. Mer. Mich.

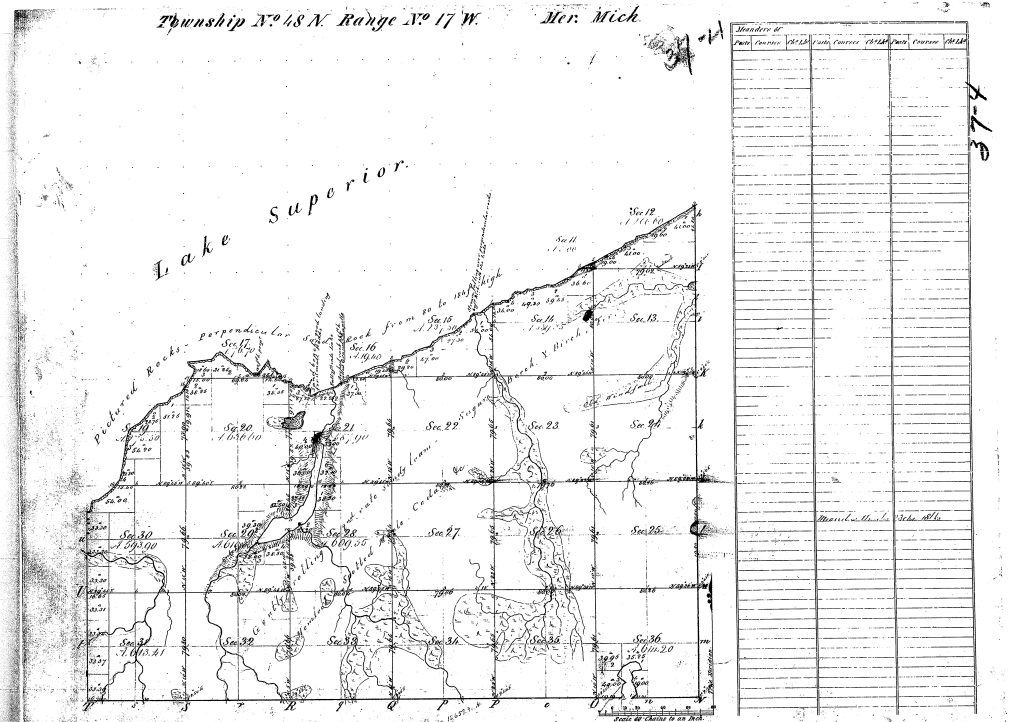

Meanders of

Magnetic Courses	Dist. Links	Magnetic Courses	Dist. Links	Magnetic Courses	Dist. Links

Total number of Acres 12 017 91

Surveys Designated.	By Whom Surveyed	Date of Contract	Amount of Surveying	When Surveyed
			M. Chs. Lks.	
Township Lines	William A. Burt	April 1. 1841	101 . 54 . 50	2nd Quar. 1841
Subdivisions	William Less	Ibid.	45 . 70 . 50	3rd & 4th Quar. 1850

The above Map of Township No. 48 North of Range No. 17 West of the Principal Meridian, Michigan, is strictly conformable to the field notes of the same, and on file in this Office, which have been examined and approved.

Surveyor General's Office
Detroit, September 1857

Charles Noble
Asst. Genl.