


Township N. III North, Range N. XII West Mer. (Me. Ter.)

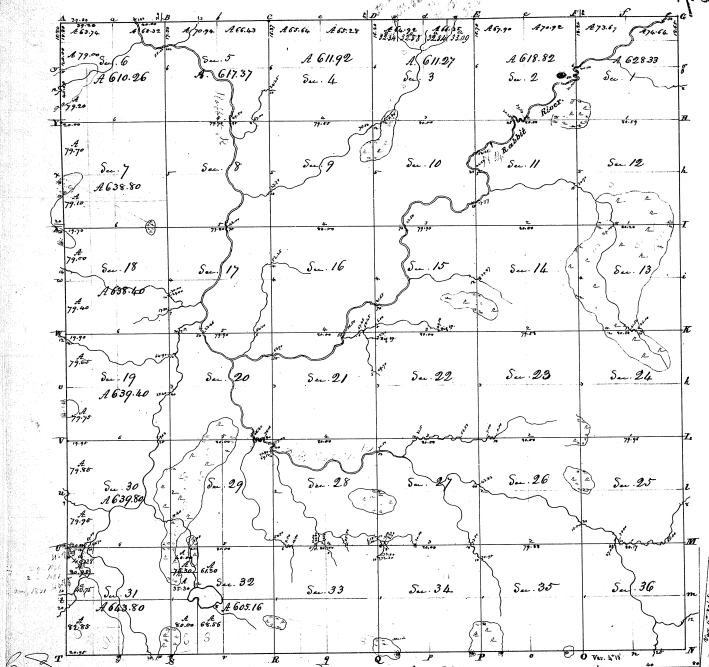

Total Contents, Acres 22,865.32

When changed	Acres of Content	Acres of Survey	When changed	Acres of Survey
Bound boundary	5.75	51.27	1731	
S. & W. Bound.	25.34	113.17	75.75	1731
Quadrantations	60.85	32		

The above Map of Township N. III North, Range N. XII West of the Meridian, in the Territory of Michigan, is strictly conformable to the Field Notes of the survey thereof on file in this office which have been examined and approved.

Surveyor General's Office
 Washington Dec. 24 1831
 M. T. Williams
 Secy. Genl.

Contents		
Sections	Acres	Sections, when 36
Manders	Common	C.E.
Subs in Sec 30		
Open at 1/2 Section		
Line of Sec 31 & 32	Subt 13.00	Subt

7-32