Township No. 52 N Range No. 33 W. Mer. Mich.

41-22

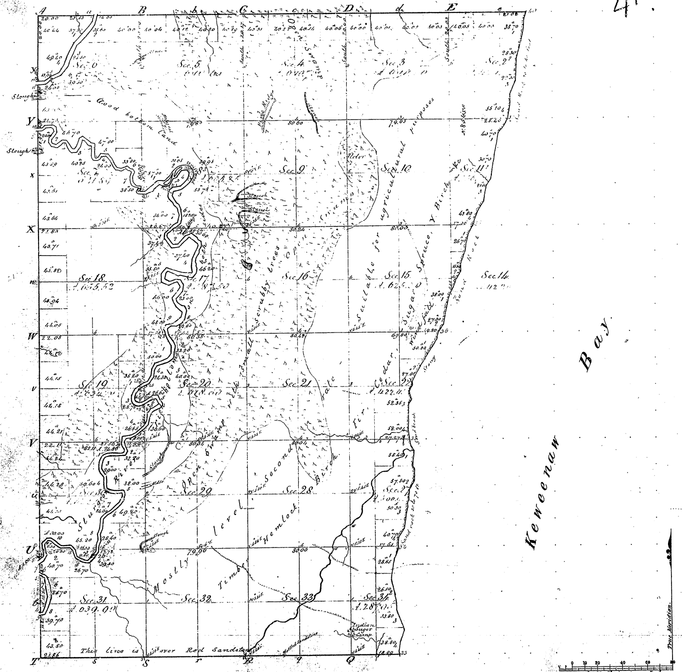

Meanders of								
Posts	Courses	Chs. Lks.	Posts	Courses	Chs. Lks.	Posts	Courses	Chs. Lks.

Total Meanders
28 miles 02 chs 47 lks

41-22

Total number of Acres 15082.45

Surveys Designated.	By Whom Surveyed.	Date of Contract.	Amount of Surveys. M. Chs. Lks.	When Surveyed.	When Charged in the Surr. Genl's acct.
Township lines,	Wm. A. Burt	June 25 1844	3 39 95	2nd Qur. 1845	
Subdivisions,	William Burt	June 14 1849	68 40 49	3rd & 4th Qur. 1849	

The above Map of Township No. 52 North of Range No. 33 West of the Principal Meridian, Michigan is strictly conformable to the field notes of the survey thereof on file in this Office, which have been examined and approved.

Surveyor General's Office, Detroit March 18 1850.

Charles Noble Surr. Genl.