




Township N<sup>o</sup> 15 N., Range N<sup>o</sup> 4 East

Mer. (Mich.)

W. Miller  
1873

Mentors of Township Range			
Section	1854	1855	1856
1			
2			
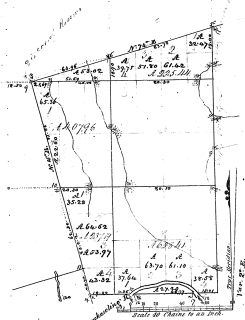

Survey Requested.	By Whom Surveyed	Date of Contract	Total number of acres 1122.25	
			Number of Sections	When Surveyed
Township Mer.	John Miller	Feb. 16 1873	3 37 00	1 <sup>st</sup> to 100
Subdivisions	do	" "	9 1 23 25	

The above Map of Township N<sup>o</sup> 15 N. of Range N<sup>o</sup> 4 East of the Principal Meridian Michigan is strictly conformable to the field notes of the survey shown on file in this Office which have been examined and approved.

Surveyor General's Office  
 Examined May 23 1873  
 W. Miller