Re-survey

Township No. 17 N. Range No. 4 East Mer: (Mich.).

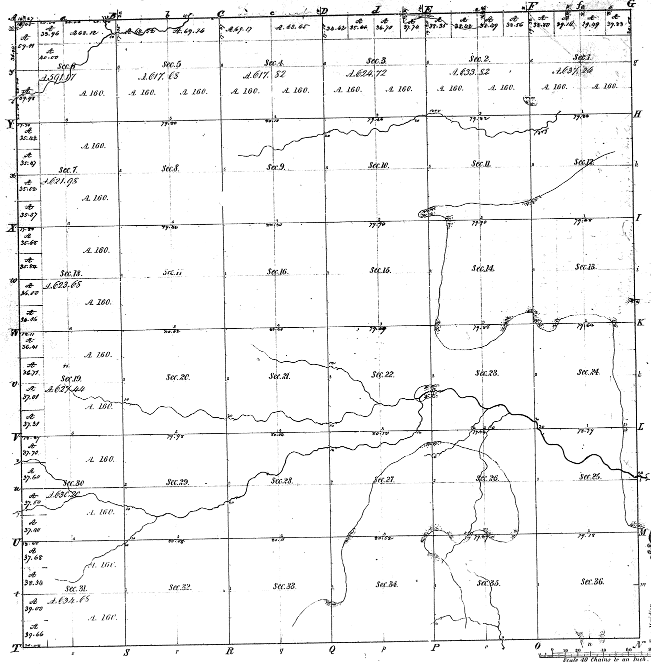

Total number of Acres: 22,860.45

Surveys Designated	By Whom Surveyed	Date of Contract	Amount of Surveys (M. Chs. Lks.)	When Surveyed	When pd. for and chd. in the Sur. Genls. acct.
S+E Township lines	Joseph Wampler		12. 00. 00	1st qr. 1822	
Subdivisions	John Brink	May 27th 1843	59. 61. 90	3d qr. 1843	4th qr. 1843
W. Boundaries	Robert Clark Jr.	Nov. 17th 1830	13. 73. 21	4th qr. 1831	

The above Map of Township No. 17 North of Range No. 4 East of the Principal Meridian Michigan is strictly conformable to the field notes of the survey thereof on file in this Office, which have been examined and approved.

Surveyor General's Office, Cincinnati Nov. 2d 1843

William Johnston
Sur. Genl.

Meanders of

Posts	Courses	Ch. Lks.	Posts	Courses	Ch. Lks.	Posts	Courses	Ch. Lks.