# Township No. 5 S. Range No. 8 W. Mer. Mich

## Islands in St. Joseph's River.

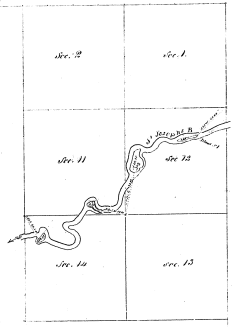


Scale of Chains to an Inch

| Meanders of | | | | | | | | |
|---|---|---|---|---|---|---|---|---|
| Posts | Courses | Ch't Lk | Posts | Courses | Ch't Lk | Posts | Courses | Ch't Lk |
| | | | | | | | | |

| Total number of Acres 14.15 | | | | | | |
|---|---|---|---|---|---|---|
| Surveys Designated. | By Whom Surv'd | Date of Contract. | Amount of Surveys M. Ch's Lks. | When Surveyed. | When Charged to the Surr Gen'l's acc't | Attention Directed. |
| Township lines. | Noah Cheverfield | Aug. 11th 1845 | 2 77. 28 | Aug. 1845 | | |
| Meanders. | | | | | | |
| Subdivisions. | | | | | | |

The above Map of the Township No. 5 South of Range No. 8 West of the Principal Meridian, Michigan is strictly conformable to the field notes of the survey thereof on file in this Office, which have been examined and approved.

Surveyor General's Office
Detroit March 1846

Lucius Lyon, Surv'r Gen'l

Approved, Sept. 1st 1846.

(2)

7-4