Township No. VI south, Range No. V West Mer. (Mic. Ter.)

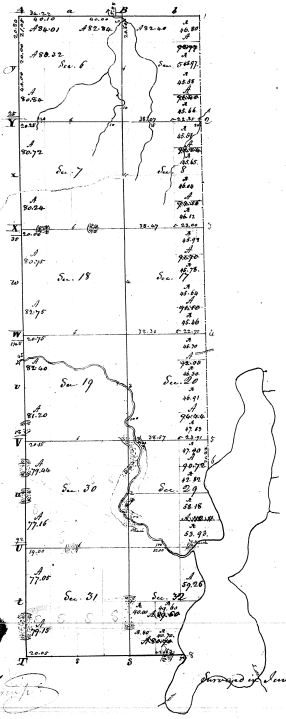

Surveyed in June 1829 by Chas. Rieder, D.S.

Scale 40 Ch. to an inch

Sec. Line

Tow. Line

4-14

Contents		
Sec.	Acres	Hds
f. NE 5	92	77
NL NW "	82	40
SL "	80	
f. S E "	91	40
S W "	160	
NL NE 6	82	84
SL "	80	
NL NW "	84	01
SL "	80	32
E E "	160	
E L S W "	80	
NL "	80	86
E L 7	320	
E L NW "	80	
NL "	80	72
E L S W "	80	
NL "	80	26
f. NE 8	91	24
f. S E "	92	16
NL "	320	
f. NE 17	91	70
f. S E "	91	10
NL "	320	
E L 18	320	
E L NW "	80	
NL "	80	75
E L S W "	80	
NL "	82	75
E L 19	320	
E L NW "	80	
NL "	82	20
E L S W "	80	
NL "	81	20
f. NE 20	92	
f. S E "	92	46
NL "	320	
f. NE 29	90	72
f. S E "	112	11
NL "	320	
E L 30	320	
E L NW "	80	
NL "	79	44
E L S W "	80	
NL "	77	16
E L 31	320	
E L NW "	80	
NL "	77	05
E L S W "	80	
NL "	79	15
f. NE 32	89	26
NW "	160	
NL SW "	89	60
SL "	80	70
Total	6740	47