Township No. 44 N. Range No. 1 E. Mer. Mich.

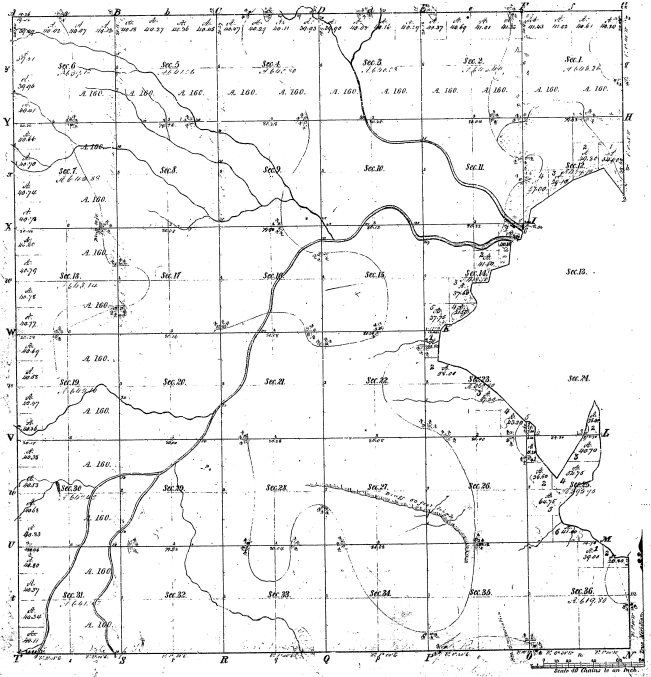

Meanders of							
Posts	Courses	Ch. Lk.	Posts	Courses	Ch. Lk.	Posts	Courses	Ch. Lk.
33-10							

33-10

Total number of Acres. 20,735.30

Surveys Designated	By Whom Surveyed	Date of Contract	Amount of Surveys	When Surveyed	When the sec. and ch. in the Sur. Gen.'s acct.
Township lines	[illegible]	[illegible]	M. Ch. Lks.	[illegible]	
Subdivisions	John Mullett	April 20th 1846	621. 31. 00	3 [illegible] 1846	

The above Map of Township No. 44 N. North of Range No. 1 E. East of the Principal Meridian Michigan is strictly conformable to the field notes of the surveys thereof on file in this Office which have been examined and approved.

Surveyor General's Office
Detroit December 20, 1846

Lucius Lyon, Sur. Gen.

Reg. Copy