# Township No. 45 N. Range No. 1 E. Mer. Mich.

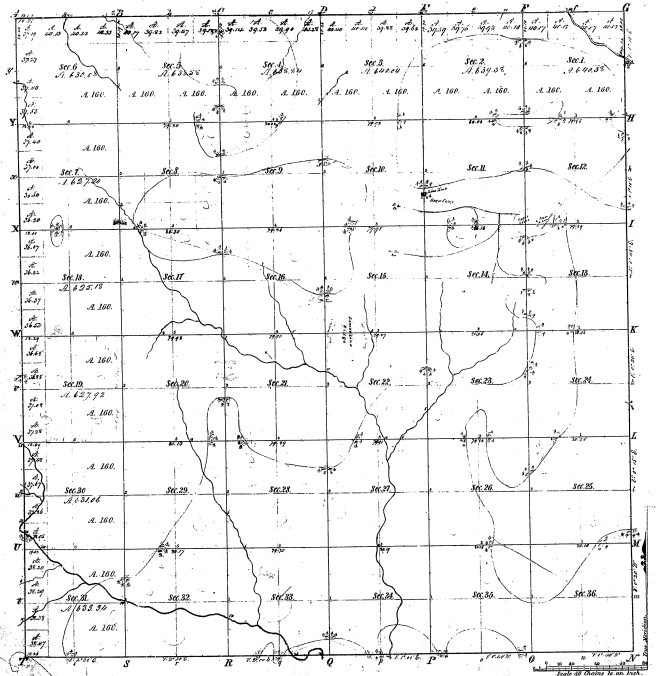


| Meanders of | | | | | | | | | |
|---|---|---|---|---|---|---|---|---|---|
| Poals | Courses | Dis. Lks. | Poals | Courses | Dis. Lks. | Poals | Courses | Dis. Lks. |
| | | | | | | | | |

33-9

1175
1152
25.5
2
10.0

Respectfully
Mack

## Total number of Acres 22973.04

| Surveys Designated | By Whom Surveyed | Date of Contract | Amount of Surveys | When Surveyed | When & on what date the Sur. Gen.l was notd. |
|---|---|---|---|---|---|
| Township lines | Do. do. | May 15th 1826 | M. Ch. Lks. | 1st qr. 1826 | |
| Subdivisions | John Mullett | Nov. 2. 1824 | 217. 72. 00 | 1st qr. 1825 | |

The above Map of Township No. 45 North of Range No. 1 East of the Principal Meridian Michigan is strictly conformable to the field notes of the survey thereof on file in this Office, which have been examined and approved.

Surveyor General's Office,
Detroit December 20th 1825

Lucius Lyon, Surr. Genl.