Islands in Grand River

Township No. 5 N. Range No. 4 W. Mer. Mich.

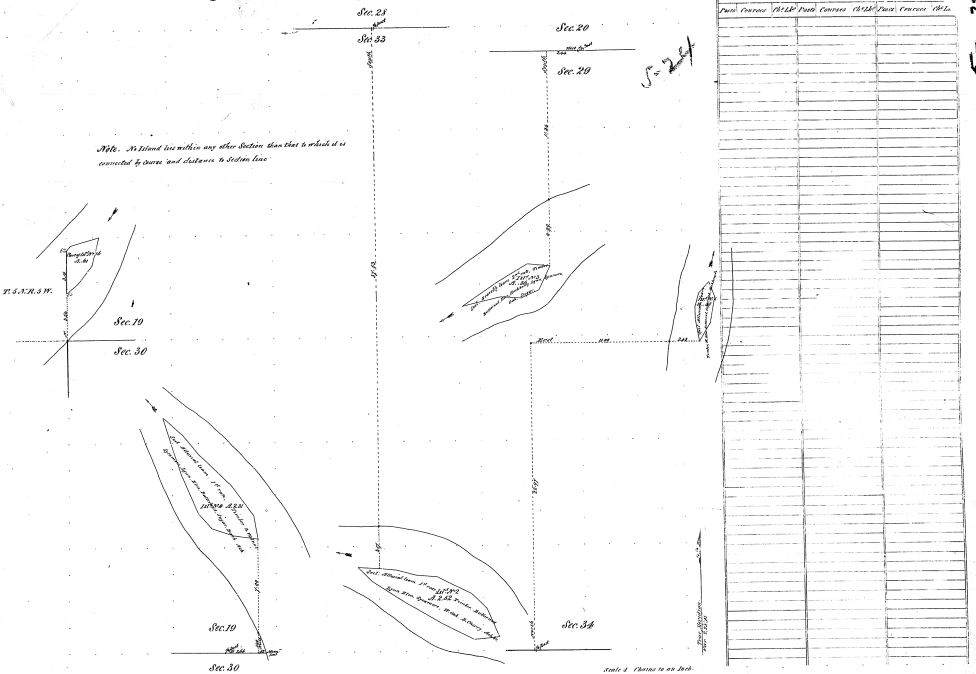

Total number of Acres 670

Survey Designated.	By Whom Surveyed.	Date of Contract.	Amount of Surveying. M.	Rd.	Lks.	When Surveyed.	When Changed in the Gen'l Plat?
Township lines.							
Subdivisions.	Thos. Whaley	Instructions May 22nd 1854				2nd Quar. 1855.	

The above Map of Township No. 5 North of Range No. 4 West of the Principal Meridian, of Michigan, is duly conformable to the field notes of the survey thereof on file in this Office, which have been examined and approved.

Surveyor General's Office, Detroit June 26 1856.

Saml. Ch. Stevens
Surv. Genl.

Com. Cong. mer.
Ref. Cong. mer.