Re Survey

Township No 26 N. Range No 2 W. Mer. Mich.

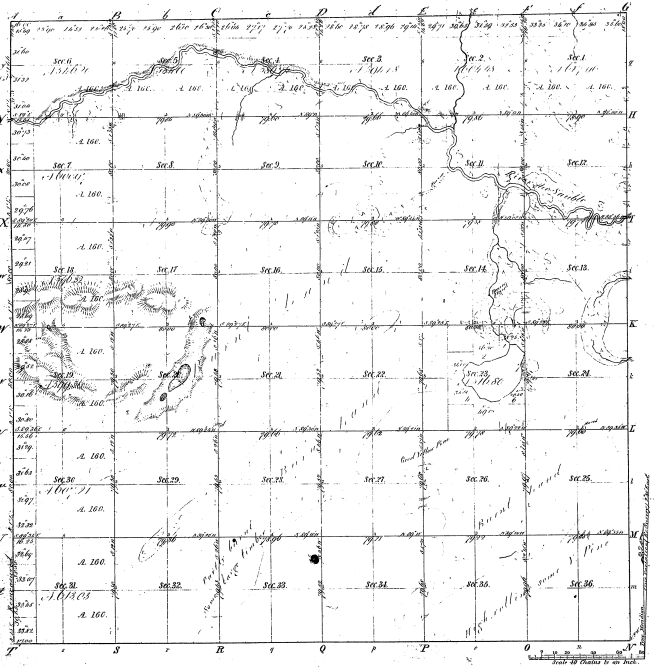

Meanders of

Posts	Courses	Chs. Lks.	Posts	Courses	Chs. Lks.	Posts	Courses	Chs. Lks.

14-19

Meanders
1 Mile 68 Chains 59 Links

14-19

Total number of Acres. 22 430.49

Surveys Designated	By Whom Surveyed	Date of Contract	Amount of Surveys	When Surveyed	When pt. are not ch. in the Surv. Gen.l acct.
Township lines	Benson & Mullett	Feb. 18th Dec. 13. 1839	M. Ch. Lks. 71 72 00	2nd Quar. 1839	
Subdivisions	Benson & Pettibone	April 15 1839	61 01 42	2nd Quar. 1839	

The above Map of Township No 26 North of Range No 2 West of the Principal Meridian Michigan is strictly conformable to the field notes of the survey thereof on file in this Office, which have been examined and approved.

Surveyor Generals Office,
Detroit Nov 20 1852.

Charles Noble
Sur. Genl.