Re-Survey

Township No. 17 N. Range No. 2 W. Mer. Michigan

13-15

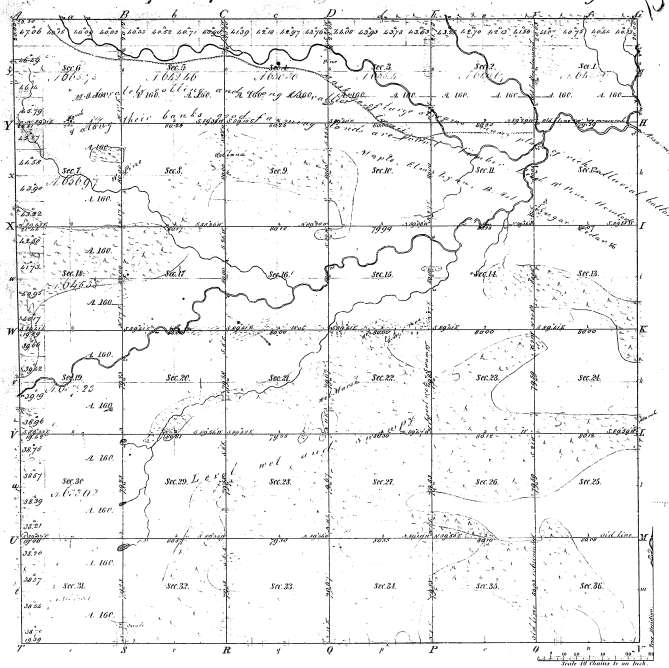

Meanders of

Posts	Courses	Ht. Lks.	Posts	Courses	Ht. Lks.	Posts	Courses	Ht. Lks.

Note. The line between Sec. 1 & 2, 11 & 12 & 35 & 36 was remained and re-established, and the old line between Sec. 2 & 3 & 36 was found to be in its proper place. The resurvey of the township was removed.

Total number of Acres 23,112.27

Surveys Designated	By Whom Surveyed	Date of Contract	Amount of Surveys	When Surveyed	Whom Surveyed
Township lines	Robt. Clark Jr.	Nov. 17. 1830	M. Ch. Lks. 79 39	4th Quar. 1831	
Subdivisions R. & S.	William A. Burt		56. 04. 55	2nd Quar. 1850	
~~Subdivisions R. & S.~~	" " "		3. 00. 25	" " "	

Showing the survey and correction

The above Map of Township No. 17 North of Range No. 2 West of the Principal Meridian Michigan is strictly conformable to the field notes of the survey thereof on file in this Office, which have been examined and approved.

Surveyor General's Office
Detroit Sept. 8 1851

Charles Bobb
Sur. Genl.