Original

13-9

Resurvey

TOWNSHIP No. 18 North RANGE No. 1 West Michigan MERIDIAN

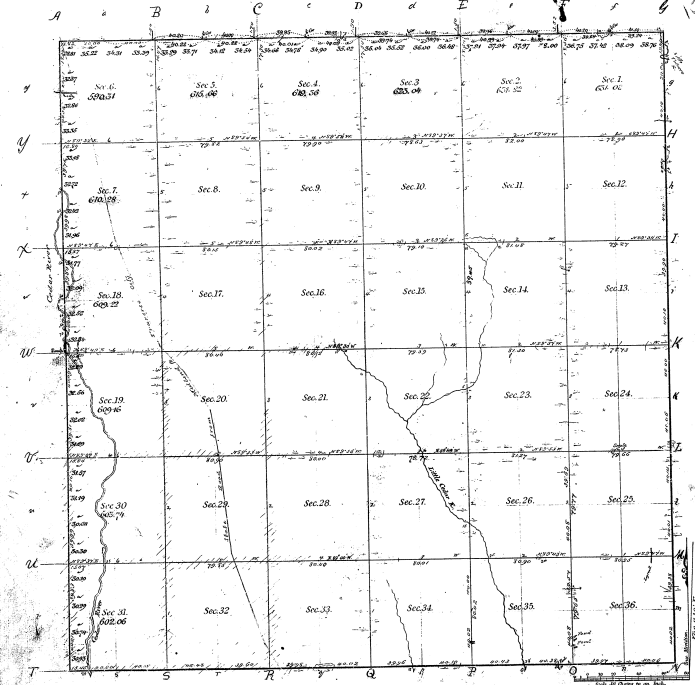

Meanders of

Posts	Courses	Ch. Lk.	Posts	Courses	Ch. Lk.	Posts	Courses	Ch. Lk.

Resurveyed under the provision of Act of Congress approved Feby 16. 1877 U.S. Stat. Vol 19 page 231.

Total number of Acres 22745.67

Surveys Designated	By Whom Surveyed	Date of Contract	Amount of Surveys	When Surveyed
Township lines	[illegible]	March 27 1877	[illegible]	[illegible]
Subdivisions	do	do	59-60-15	January 1877

The above Map of Township No. 18 North of Range No. 1 West of the Michigan Meridian, Michigan is strictly conformable to the field notes of the survey thereof on file in this Office which have been examined and approved.

Department of the Interior
Surveyor General's Office
Council Bluffs Office
August 8, 1877

J. Alvinnum
Surv. Genl.
Commissioner