Township No. 29 N. Range No. 10 West Mer. (Mich.)

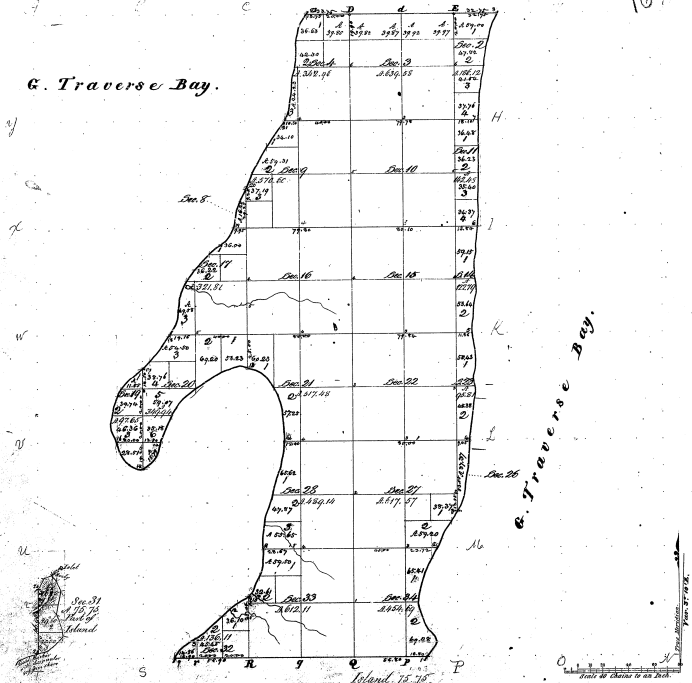

Total number of Acres 6,354.76

Surveyor Designated.	By Whom Surveyed.	Date of Contract.	Commencement of Surveying. M. Day	Completion of Surveying. M. Day	When Surveyed.	When Changed to the Dist. Surr.	When Approved.
Township lines	Silas Shelgon	Jan 24 1839	4. 20. 20.	2. gr. 1839	3. gr. 1839		
Subdivisions			20. 20. 21				
Island	George Hinsdale	Recd. Aug 20 1839					

The above Map of Township No. 29 N. of Range No. 10 West Principal Meridian, Michigan, is strictly conformable to the field notes of survey returned to this Office, which have been examined and approved.

Surveyor Generals Office, Cincinnati, Oct 15. 1839.

G. S. Gaines Surv. Genl.

Sidney Sheldon 29-10

Number of Point	Record of Traverses 1 Day Course	Dist. Lks	Point	Course	Dist. Lks	Point	Course	Dist. Lks
1.	N 46 E	4.00		N 26 E	6.00			
	N 26 W	25.00		N 79 E	15.00			
	N 13 E	22.00		N 12 E	24.00			
2.	N 38 W	21.00		N 20 W	12.00			
	N 79 E	17.00		N 8 E	17.00			
3.	N 30 W	24.00	22.	N 30 E	5.91			
	N 38 E	11.00						
	N 7 E	11.00						
	N 16 E	14.00						
4.	N 62 W	14.00						
	N 12 E	7.00						
	N 7 E	14.00						
	N 12 W	7.00						
	N 12 W	7.00						
5.	N 37 W	6.00						
	N 6 E	17.00						
	N 7 E	14.00						
	N 37 W	22.00						
6.	N 62 E	26.00						
	N 12 E	14.00						
7.	North	24.00						
	N 12 E	20.00						
	N 6 E	20.00						
8.	N 30 W	16.00						
9.	N 31 E	6.00						
	N 20 E	31.00						
	N 42 E	12.00						
	N 52 E	16.00						
10.	N 24 E	16.00						
	N 42 E	6.00						
	N 74 E	22.00						
11.	N 34 E	6.31						
	N 42 E	6.00						
	N 18 E	6.00						
	N 24 E	17.00						
	N 22 E	16.00						
12.	N 7 E	24.91						
	North	11.00						
	N 12 W	11.00						
	N 27 W	21.00						
13.	N 17 W	24.00						
	N 17 W	5.00						
	N 27 W	22.00						
	N 36 W	21.00						
	N 48 W	3.00						
14.	N 21 W	23.00						
	N 17 W	5.00						
15.	N 43 W	6.00						
	N 43 W	5.00						
	N 74 W	7.00						
	N 36 W	12.00						
16.	N 42 W	8.00						
	N 27 W	11.00						
	N 16 E	12.00						
	N 12 E	16.00						
17.	N 6 E	12.00						
18.	N 22 W	32.00						
	N 6 E	12.00						
	N 11 E	14.00						
	N 36 E	19.00						
	N 22 E	9.00						
	N 24 E	13.00						
	N 26 E	8.00						
19.	N 22 E	11.00						
	N 11 E	15.00						
20.	N 13 E	12.00						
	N 16 E	24.00						
21.	N 24 E	24.00						