Township N°. 55 N. Range N°. 35 W. Mer. Michigan

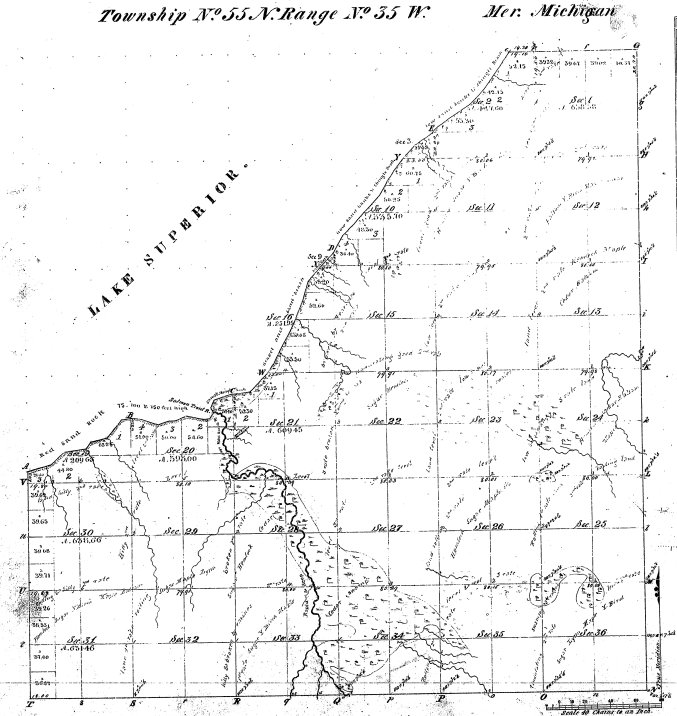

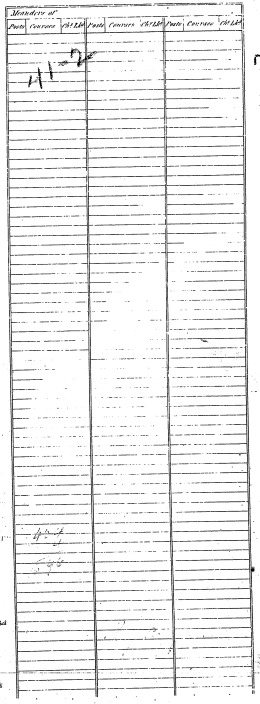

11-25

7-11

Total number of Acres 15615.10

Surveys Designated.	By Whom Surveyed.	Date of Contract.	Amount of Surveying thereby Contracted for.	When Surveyed.	When Charged in the Surveyor's Acct.
Township lines	Wm H. Brunder	June 8th 1846	14.75.20	Sept 1845	
Subdivisions	Wm H. Brunder	June 8th 1846	14.75.20	Sept 1845	

The above Map of Township N°. 55 North of Range N°. 35 W of the Principal Meridian, Michigan is strictly conformable to the field notes of the survey thereof on file in this Office which have been examined and approved.

Surveyor General's Office, Detroit, Mich. 1847

Lucius Lyon, Surv. Genl.